

Washington

M 2007

7-14-80

MISSISSIPPI  
 BOARD OF WATER COMMISSIONERS  
 416 North State Street  
 Jackson, Mississippi 39201

WATER WELL DRILLERS LOG

14 July 1980  
date well completed

Lambert Drilling  
firm name

Wash  
county well located

LANDOWNER:	description of formations encountered	from	to
Dorothy Stewart Hollandale, Miss. (mailing address)			
WELL LOCATION: sec. 36 T. 16 N. R. 18 E. S. 6 W. Hollandale	Sand	18	85
4 miles (distance) of (direction) of (nearest town)	fine gravel	85	160
WELL PURPOSE: none (home, irrigation, municipal, industrial)	Clay	160	280
WELL COMPLETION DATA:	ROCK	280	281
(1) diameter (inches) 2	Clay & sand	281	320
(2) total depth (feet) 450	Clay & sand	320	345
(3) static water level (feet) 30 below top of ground.	Sand light	245	260
(4) casing PVC 440 (material) (depth)	Sand med	260	420
(size) If telescope see back.	Sand good	420	460
(5) screen 10 450-440 (length) (depth to top)			
2" PVC (size) (material)			
(6) pump 1 10 (HP) (yield gpm)			
elect (type power)			
(7) electric log (yes or no)			
(organization running log)			
(8) how well bottom plugged back pass.			
DRILLERS REMARKS:			


DEPT. OF NATURAL RESOURCES  
 BUREAU OF LAND & WATER RESOURCES

DEC 15 1980

RECEIVED

If well telescopes please sketch and show depths.

GROUND LEVEL

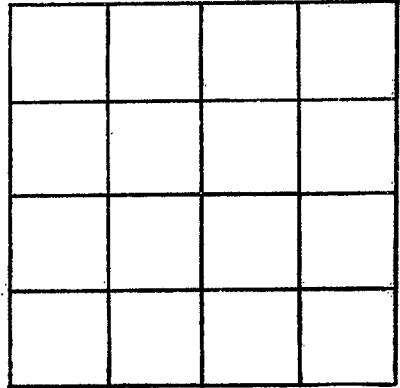

SECTION \_\_\_\_\_

Please indicate well location X.

ADDITIONAL INFORMATION

If more than one screen,  
show locations of each on sketch.