

MISSISSIPPI DEPARTMENT OF NATURAL RESOURCES

Bureau of Land and Water Resources

Southport Mall

P.O. Box 10631

Jackson, Mississippi 39209

WATER WELL DRILLERS LOG

Washington
M
2008

4 Nov 1981 Lambert Drilling Wash.
 date well completed firm name county well located

| LANDOWNER: | description of formations encountered | from | to |
|---|---------------------------------------|------------|------------|
| (mailing address) | | | |
| <u>Highlite Pit.</u> | <u>Clay</u> | <u>0</u> | <u>15</u> |
| <u>Arcola, Miss</u> | <u>Sand</u> | <u>15</u> | <u>60</u> |
| WELL LOCATION: sec. <u>18</u> T. <u>16</u> N. R. <u>6</u> E. <u>3</u> miles <u>SE</u> of <u>Arcola</u> (distance) (direction) (nearest town) | <u>Sand & pea gravel</u> | <u>60</u> | <u>95</u> |
| WELL PURPOSE: <u>none</u> (home, irrigation, municipal, industrial) | <u>Gravel</u> | <u>95</u> | <u>128</u> |
| WELL COMPLETION DATA: (1) diameter (inches) <u>4x2</u> | <u>Clay</u> | <u>128</u> | <u>150</u> |
| (2) total depth (feet) <u>420 ft</u> | <u>Clay & sand</u> | <u>150</u> | <u>260</u> |
| (3) static water level (feet) <u>41</u> below above top of ground. | <u>Sand med.</u> | <u>260</u> | <u>285</u> |
| (4) casing <u>PVC</u> , <u>400</u> , (material) (depth) | <u>Sand, good</u> | <u>285</u> | <u>420</u> |
| <u>4x2</u> if telescope see back. (size) | | | |
| (5) screen <u>20</u> , <u>420-400</u> (length) (depth to top) | | | |
| <u>2</u> , <u>PVC</u> (size) (material) | | | |
| (6) pump <u>1</u> , <u>20</u> (HP) (yield gpm) | | | |
| <u>elect</u> (type power) | | | |
| (7) electric log <u>no</u> (yes or no) | | | |
| (organization running log) | | | |
| (8) how well bottom plugged <u>back press</u> | | | |
| DRILLERS REMARKS: | | | |

DEPT. OF NATURAL RESOURCES
 BUREAU OF LAND & WATER RESOURCES

FEB - 9 1982

RECEIVED


If well telescopes please sketch and show depths.

GROUND LEVEL

4" 140

2" 400

2' 5" 420

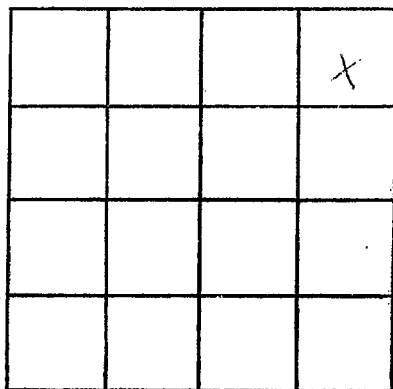

SECTION 18

Please indicate well location X.

ADDITIONAL INFORMATION

If more than one screen, show locations of each on sketch.