

MISSISSIPPI DEPARTMENT OF NATURAL RESOURCES

Bureau of Land and Water Resources

Southport Mall

P.O. Box 10631

Jackson, Mississippi 39209

WATER WELL DRILLERS LOG

Washington
M
2009

Feb. 15 1983 Larry's well & pump Washington
 date well completed firm name county well located

| LANDOWNER: <u>Dale Stokes</u> | description of formations encountered | from | to |
|--|--|------------------------------------|---------------------------------------|
| <u>Acicola, Mo</u> (mailing address) | | | |
| WELL LOCATION: sec. <u>13</u> T <u>16</u> N R <u>6</u> E S W <u>1</u> miles <u>East</u> of <u>Parlove</u> (distance) (direction) (nearest town) | <u>clay</u> <u>Sand</u> <u>Sand & gravel</u> | <u>0</u> <u>20</u> <u>80</u> | <u>20</u> <u>80'</u> <u>140</u> |
| WELL PURPOSE: (home, irrigation, municipal, industrial) | | | |
| WELL COMPLETION DATA: (1) diameter (inches) <u>4" x 2"</u> (2) total depth (feet) <u>500</u> (3) static water level (feet) <u>22</u> <u>below</u> <u>above</u> top of ground. (4) casing <u>plastic</u> <u>500' / 460'</u> (material) (depth) (size) if telescope see back. (5) screen <u>40'</u> <u>460'</u> (length) (depth to top) <u>5"</u> <u>plastic</u> (size) (material) (6) pump <u>2</u> <u>40</u> (HP) (yield gpm) (type power) (7) electric log <u>NO</u> (yes or no) (organization running log) | | | |
| (8) how well bottom plugged _____ | | | |

DEPT. OF NATURAL RESOURCES
 BUREAU OF LAND & WATER RESOURCES


MAY 5 - 1983

RECEIVED

DRILLERS REMARKS:

If well telescopes please sketch and show depths.

GROUND LEVEL

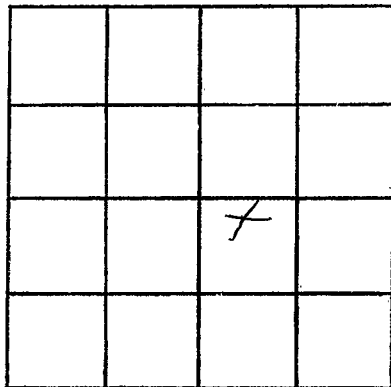

SECTION 13

Please indicate well location X.

ADDITIONAL INFORMATION

If more than one screen,
show locations of each on sketch.