

MISSISSIPPI DEPARTMENT OF NATURAL RESOURCES

Bureau of Land and Water Resources

Southport Mall

P.O. Box 10631

Jackson, Mississippi 39209

WATER WELL DRILLERS LOG

WASHINGTON
M 2010
2-15-83

Feb 15 19 83 Garry's Well Drilling Washington
date well completed firm name county well located

LANDOWNER: Dale Stokes	description of formations encountered	from	to
Arcola, Miss (mailing address)	clay Sand	0	20
WELL LOCATION: sec. 12 T 16 N R. E 1 miles South of Tralake (distance) (direction) (nearest town)	Sand & gravel clay clay & sand Sand	20 80 140 220 400	80 140 240 500
WELL PURPOSE: (home, irrigation, municipal, industrial)			
WELL COMPLETION DATA: 100'-41"			
(1) diameter (inches) 4" x 2"			
(2) total depth (feet) 500'			
(3) static water level (feet) 22 below top of ground.			
(4) casing plastic, 460 (material) (depth)			
(size) if telescope see back.			
(5) screen 40 (length) 460 (depth to top)			
2" (size) plastic (material)			
(6) pump 2 (HP) 40 (yield gpm)			
Kestris (type power)			
(7) electric log No (yes or no)			
(organization running log)			
(8) how well bottom plugged Back Wash Valve			
DRILLERS REMARKS:			


DEPT. OF NATURAL RESOURCES
BUREAU OF LAND & WATER RESOURCES

JUN - 8 1983

RECEIVED

If well telescopes please sketch and show depths.

GROUND LEVEL

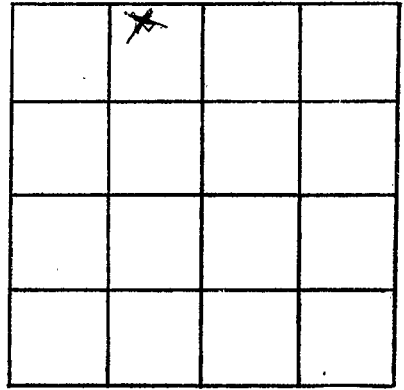

SECTION 2

Please indicate well location X.

ADDITIONAL INFORMATION

If more than one screen,
show locations of each on sketch.