

MISSISSIPPI DEPARTMENT OF NATURAL RESOURCES

Bureau of Land and Water Resources

Southport Mall

P.O. Box 10631

Jackson, Mississippi 39209

WATER WELL DRILLERS LOG

Washington
M
2011

3-29-83
date well completed

Schultz Drilling
firm name

Washington
county well located

LANDOWNER: CC WARE
DARLOVE, MS

(mailing address)

WELL LOCATION:

sec. 14 T. 16 N. R. 6 E
6 miles NE of Holantale
(distance) (direction) (nearest town)

WELL PURPOSE:

(home, irrigation, municipal, industrial)

WELL COMPLETION DATA:

- (1) diameter (inches) 2"
- (2) total depth (feet) 600'
- (3) static water level (feet) 29' below top of ground.
- (4) casing PVC 590' (material) (depth)
- (5) screen 10' 590' (length) (depth to top)
2" PVC (size) (material)
- (6) pump 10 (HP) (yield gpm)
ELE (type power)
- (7) electric log NO (yes or no)
X (organization running log)
- (8) how well bottom plugged b/w

description of formations encountered

from

to

CLAY	0	20
SAND gravel	20	160
Shale	160	380
SAND	380	440
CLAY	440	540
SAND	540	600

DRILLERS REMARKS:


DEPT. OF NATURAL RESOURCES
BUREAU OF LAND & WATER RESOURCES

APR 20 1983

RECEIVED

If well telescopes please
sketch and show depths.

GROUND LEVEL

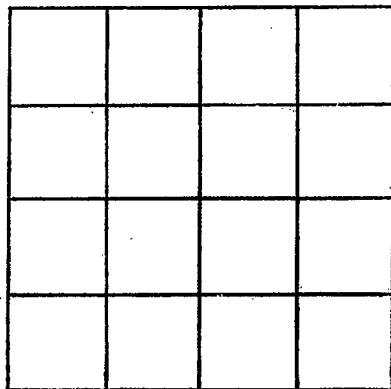

SECTION _____

Please indicate well location X.

ADDITIONAL INFORMATION

If more than one screen,
show locations of each on sketch.