

MISSISSIPPI DEPARTMENT OF NATURAL RESOURCES

Bureau of Land and Water Resources

Southport Mall

P.O. Box 10631

Jackson, Mississippi 39209

WATER WELL DRILLERS LOG

Washington  
M  
2012

18 Mar 74 19 Lambert Drilling Wash  
date well completed firm name county well located

LANDOWNER:	description of formations encountered	from	to
Everett Spells Hollandale, Miss. (mailing address)			
WELL LOCATION:	Mixed	20	40
sec. <u>2</u> T. <u>16</u> N. R. <u>6</u> E. <u>6</u> miles <u>N/E</u> of <u>Hollandale</u> (distance) (direction) (nearest town)	Sand	40	80
WELL PURPOSE: <u>None</u> (home, irrigation, municipal, industrial)	Gravel	80	132
WELL COMPLETION DATA:	Clay	132	182
(1) diameter (inches) <u>4x2</u>	Clay & sand	182	300
(2) total depth (feet) <u>500</u>	Sand & clay	300	410
(3) static water level (feet) <u>22</u> below above top of ground.	Sand & med	410	440
(4) casing <u>PVC</u> , <u>470</u> (material) (depth)	Sand	440	500
<u>4x2</u> (size) If telescope see back.			
(5) screen <u>30</u> , <u>500-470</u> (length) (depth to top)			
<u>2</u> , <u>PVC</u> (size) (material)			
(6) pump <u>1</u> , <u>20</u> (HP) (yield gpm)			
<u>elect</u> (type power)			
(7) electric log <u>no</u> (yes or no)			
(organization running log)			
(8) how well bottom plugged <u>back mess.</u>			
DRILLERS REMARKS:			

DEPT. OF NATURAL RESOURCES  
BUREAU OF LAND & WATER RESOURCES

MAR 22 1984

RECEIVED


If well telescopes please sketch and show depths.

GROUND LEVEL

140 4"

470 2"

500 2" 50%

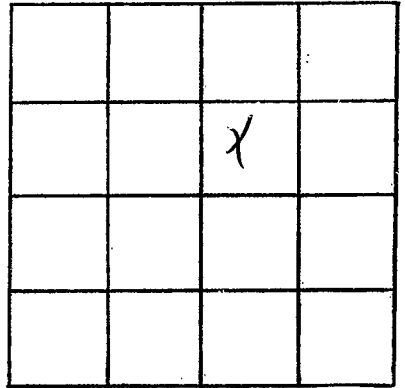

SECTION 2

Please indicate well location X.

ADDITIONAL INFORMATION

If more than one screen,  
show locations of each on sketch.