

MISSISSIPPI DEPARTMENT OF NATURAL RESOURCES

Bureau of Land and Water Resources

Southport Mall

P.O. Box 10631

Jackson, Mississippi 39209

WATER WELL DRILLERS LOG

WASHINGTON
M 2013

12-10-1986 date well completed
Schultz Drilling firm name
Washington county well located

LANDOWNER:	description of formations encountered	from	to
FARM Fresh Catfish Hollandale, MS (mailing address)	CLAY COARSE SAND	0 18	18 90
<p>WELL LOCATION:</p> <p>sec. 30 T 16 N R 7 E 3 miles SE of Arcola (distance) (direction) (nearest town)</p>			
<p>WELL PURPOSE: HOME (home, irrigation, municipal, industrial)</p>			
<p>WELL COMPLETION DATA:</p>			
<p>(1) diameter (inches) 2"</p>			
<p>(2) total depth (feet) 90'</p>			
<p>(3) static water level (feet) 26' below above top of ground.</p>			
<p>(4) casing PVC, 80' (material) (depth)</p>			
<p>(size) If telescope see back.</p>			
<p>(5) screen 10' 80' (length) (depth to top) 2" PVC (size) (material)</p>			
<p>(6) pump 1 10 (HP) (yield gpm) elc (type power)</p>			
<p>(7) electric log NO (yes or no) X (organization running log)</p>			
<p>(8) how well bottom plugged CAP</p>			
<p>DRILLERS REMARKS:</p>			


RECEIVED

FEB 06 1987

Department of Natural Resources
Bureau of Land & Water Resources

If well telescopes please sketch and show depths.

GROUND LEVEL

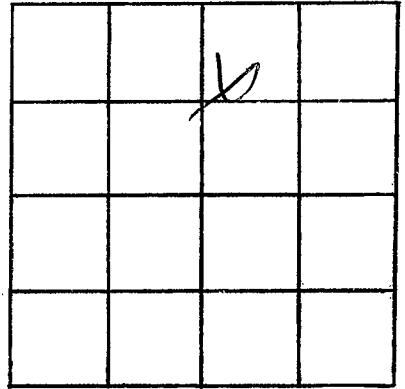

SECTION 30

Please indicate well location X.

ADDITIONAL INFORMATION

If more than one screen,
show locations of each on sketch.