

MISSISSIPPI DEPARTMENT OF NATURAL RESOURCES

Bureau of Land and Water Resources

Southport Mall

P.O. Box 10631

Jackson, Mississippi 39209

WATER WELL DRILLERS LOG

WASHINGTON  
M 2014

6-25 1987 Schultz Drilling Washington  
date well completed firm name county well located

LANDOWNER: BON GENIE PLANT.  
Rt. 2. BOX 170  
Hollandale MS  
(mailing address)

description of formations encountered	from	to
CLAY	0	20
SAND + GRAVEL	20	137
CLAY	137	200
SAND	200	420

WELL LOCATION:  
sec. 20 T. 16 N. R. 6 E.  
3 miles N of Hollandale  
(distance) (direction) (nearest town)

WELL PURPOSE:  
(home, irrigation, municipal, industrial)

WELL COMPLETION DATA:



- (1) diameter (inches) 4" X 2"
- (2) total depth (feet) 420'
- (3) static water level (feet) 31 -below  
above  
top of ground.
- (4) casing PVC 400'  
(material) (depth)
- \_\_\_\_\_ if telescope see back.  
(size)
- (5) screen 20' 400'  
(length) (depth to top)  
2" PVC  
(size) (material)
- (6) pump 1/2 30  
(HP) (yield gpm)  
ele  
(type power)
- (7) electric log NO  
(yes or no)  
X  
(organization running log)
- (8) how well bottom plugged b/w

RECEIVED  
OCT 05 1987

Department of Natural Resources  
Bureau of Land & Water Resources

DRILLERS REMARKS:

If well telescopes please sketch and show depths.

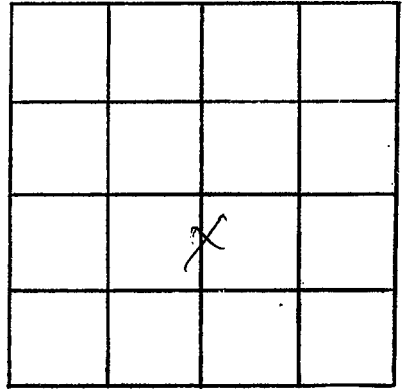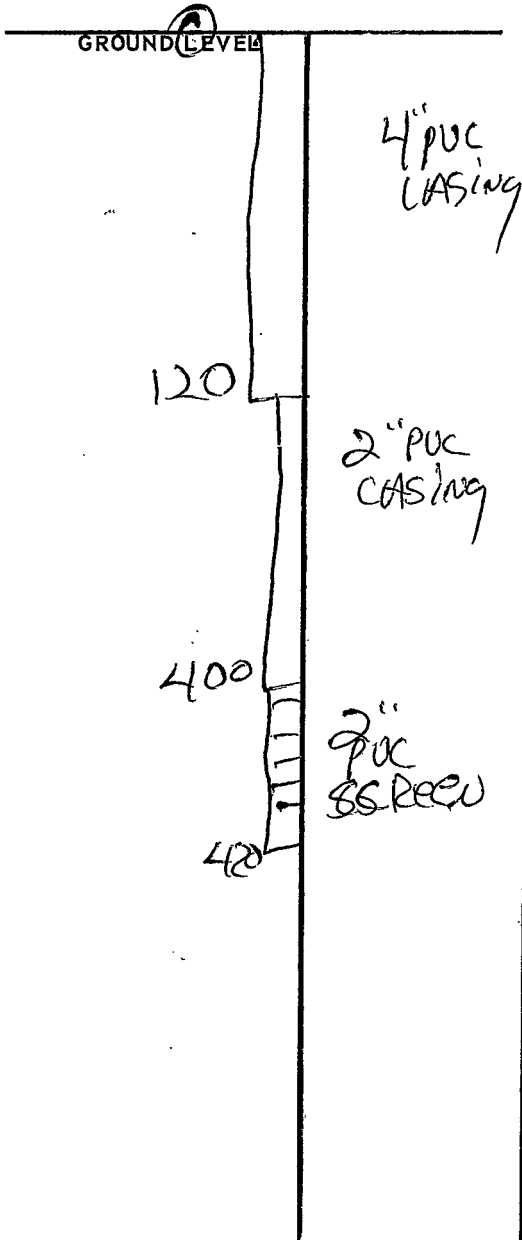

SECTION 20

Please indicate well location X.

ADDITIONAL INFORMATION

A series of horizontal lines for writing additional information.

If more than one screen, show locations of each on sketch.