

MISSISSIPPI DEPARTMENT OF NATURAL RESOURCES

Bureau of Land and Water Resources

COUNTY WELL LOCATED Washington	
WELL NUMBER M	CODED
DATE WELL COMPLETED 2017 4-25-89	

1663

PERMIT NUMBER
NAME OF DRILLING FIRM IRRIGATION EQUIPMENT
601/887-2555
INDIANOLA, MS

P.O. Box 10631
Jackson, Mississippi 39209
WATER WELL DRILLERS LOG

NAME & MAILING ADDRESS OF LANDOWNER		
Big Delta Planting		
514 ARNOLD AVE.		
Greenville, MS		
WELL LOCATION:	SEC	TOWNSHIP
	23	16
		N 6 W
DISTANCE	DIRECTION	NEAREST TOWN
1 Miles	West	of DARLOVE
OTHER LANDMARK		
WELL PURPOSE: Home, Irrigation, Municipal, Industrial, Fish Pond, etc.		
IRRIGATION		

PUMP DATA		
PUMP TYPE (Circle One): Submersible, <u>Turbine</u> , Jet, Flowing Well, Other (Describe) _____		
POWER TYPE (Circle One): Electric, Tractor, <u>Diesel</u> , Gasoline, Butane, Other (Describe) _____ H/P <u>60</u>		
Pump Capacity (GPM)	No. of Stages	Setting Depth
3000	1	60 FT.
PUMP TEST		
Well yielded _____ GPM with a drawdown of _____ ft. after _____ hours of pumping		

WELL DATA		
Well Depth	Casing Diameter (In.)	Casing Length (Ft.)
115'	16	75
Type of Casing	Hole Depth	Depth to Static Water Level
PVC	115'	30'
TYPE OF COMPLETION: (Circle One or More): <u>Gravel Packed</u> , Underreamed, Telescoped, Natural Development, Open Hole, Other (Describe) _____		
Top of Lap Pipe or Reduction in Casing		
FEET	IF TELESCOPED OR MORE THAN ONE SCREEN: USE BACK PAGE	

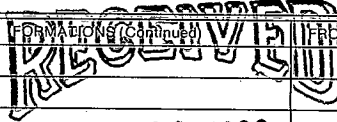
LOG DATA	
TYPE OF LOG RUN (Circle One): Electric, Gamma Ray, Density, Sonic, Neutron, Other (Describe) _____ No Log Run,	
Name of Organization Running Log	

SCREEN DATA		
Diameter - Inches	Length - Feet	Slot Size - Inches
16	40	.030
Screen Type	Depth to Bottom - Feet	
pvc	115	

GEOLOGIC DATA (Office Use Only)			
Surface Elev.	Geologic Unit	Unit Thickness	Depth to Top
Subs. SWL	Date	Analysis	Aquifer Test

Driller's Remarks

DESCRIPTION OF FORMATIONS ENCOUNTERED	FROM	TO
CLAY	0	15
medium sand	15	50
FINE SAND	50	70
medium sand	70	80
COARSE SAND + gravel	80	105
medium sand	105	115

 APR 28 1999 Department of Natural Resources Bureau of Land & Water Resources	
IF MORE SPACE IS NEEDED, USE BACK	

If well telescopes please sketch and show depths.

IRRIGATION EQUIPMENT
601/887-2555
INDIANOLA, MS

GROUND LEVEL

X			

SECTION 23

Please indicate well location X.

ADDITIONAL INFORMATION

[Faint, illegible text]

If more than one screen,
show location of each on sketch.