

MISSISSIPPI DEPARTMENT OF NATURAL RESOURCES

Bureau of Land and Water Resources

COUNTY WELL LOCATED <i>Washington</i>	
WELL NUMBER <i>M</i>	CODED
<i>2022</i>	
DATE WELL COMPLETED <i>4-5-90</i>	

PERMIT NUMBER
NAME OF DRILLING FIRM <i>Schultz Drilling</i>

P.O. Box 10631
Jackson, Mississippi 39209
WATER WELL DRILLERS LOG

NAME & MAILING ADDRESS OF LANDOWNER <i>Mark Parish</i>			
<i>P.O. Box 361</i>			
<i>Arcola MS</i>			
WELL LOCATION:	SEC	TOWNSHIP	RANGE
	<i>34</i>	<i>16</i>	<i>S 5 E</i>
DISTANCE	DIRECTION	NEAREST TOWN	
<i>10</i> Miles	<i>E</i>	of <i>Hollandale</i>	
OTHER LANDMARK			
WELL PURPOSE: Home, <input checked="" type="checkbox"/> Irrigation, <input type="checkbox"/> Municipal, <input type="checkbox"/> Industrial, <input type="checkbox"/> Fish Pond, etc.			

PUMP DATA		
PUMP TYPE (Circle One): Submersible, <input checked="" type="checkbox"/> Turbine, <input type="checkbox"/> Jet, <input type="checkbox"/> Flowing Well, Other (Describe) _____		
POWER TYPE (Circle One): Electric, <input type="checkbox"/> Tractor, <input checked="" type="checkbox"/> Diesel, <input type="checkbox"/> Gasoline, <input type="checkbox"/> Butane, Other (Describe) _____		
Pump Capacity (GPM) <i>3000</i>	No. of Stages <i>1</i>	Setting Depth <i>60</i> FT.
PUMP TEST		
Well yielded _____ GPM with a drawdown of _____ ft. after _____ hours of pumping		

WELL DATA		
Well Depth <i>120 ft</i>	Casing Diameter (In.) <i>16</i>	Casing Length (Ft.) <i>80</i>
Type of Casing <i>pvc</i>	Hole Depth <i>120 ft</i>	Depth to Static Water Level
TYPE OF COMPLETION: (Circle One or More): <input checked="" type="checkbox"/> Gravel Packed, <input type="checkbox"/> Underreamed, <input type="checkbox"/> Telescoped, <input type="checkbox"/> Natural Development, <input type="checkbox"/> Open Hole, <input type="checkbox"/> Other (Describe) _____		
Top of Lap Pipe or Reduction in Casing		
FEET	IF TELESCOPED OR MORE THAN ONE SCREEN: USE BACK PAGE	

LOG DATA	
TYPE OF LOG RUN (Circle One): Electric, Gamma Ray, Density, Sonic, <input checked="" type="checkbox"/> No Log Run, Neutron, Other (Describe) _____	
Name of Organization Running Log	

SCREEN DATA		
Diameter - Inches <i>16</i>	Length - Feet <i>40 ft</i>	Slot Size - Inches <i>.050</i>
Screen Type <i>pvc</i>	Depth to Bottom - Feet <i>120 ft</i>	

GEOLOGIC DATA (Office Use Only)			
Surface Elev.	Geologic Unit	Unit Thickness	Depth to Top
Subs. SWL	Date	Analysis	Aquifer Test



Driller's Remarks

DESCRIPTION OF FORMATIONS ENCOUNTERED	FROM	TO	FORMATIONS (Continued)	FROM	TO
<i>Clay</i>	<i>0</i>	<i>19'</i>	RECEIVED <i>JUN 08 1990</i> Department of Natural Resources Bureau of Land & Water Resources		
<i>Sand</i>	<i>19</i>	<i>40</i>			
<i>Gravel & Sand</i>	<i>40</i>	<i>120</i>			

IF MORE SPACE IS NEEDED, USE BACK

If well telescopes please sketch and show depths.

GROUND LEVEL

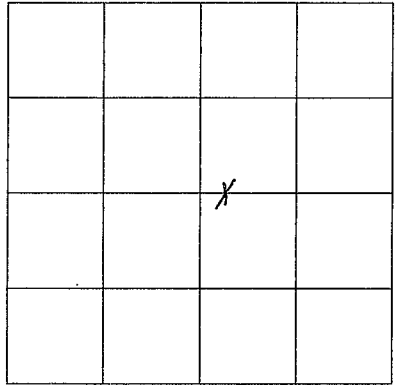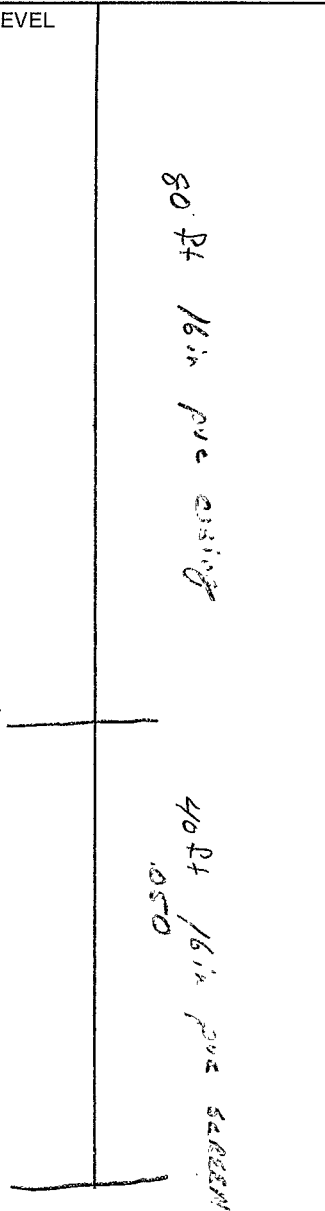

SECTION 34

Please indicate well location X.

ADDITIONAL INFORMATION

If more than one screen,
show location of each on sketch.