

MISSISSIPPI DEPARTMENT OF ENVIRONMENTAL  
Bureau of Land and Water

P. O. Box 1663  
Jackson, MS 39289-0163  
WATER WELL DRILLERS LOG

COUNTY WELL LOCATED  
Washington

WELL NUMBER M CODED

2027

DATE WELL COMPLETED  
6-22-92

PERMIT NUMBER

NAME OF DRILLING FIRM  
Schudco Ltd

NAME & MAILING ADDRESS OF LANDOWNER  
DAN THOMASSEN

Hollandale 9MS

WELL LOCATION: SEC 26 TOWNSHIP 16 RANGE 6  
N S E W

DISTANCE 4 Miles DIRECTION NE of NEAREST TOWN Hollandale

OTHER LANDMARK

WELL PURPOSE: Home Irrigation Municipal, Industrial, Fish Pond, etc.

PUMP DATA

PUMP TYPE (Circle One):  
Submersible, Turbine Jet Flowing Well,  
Other (Describe)

POWER TYPE (Circle One):  
Electric, Tractor, Diesel Gasoline, Butane,  
Other (Describe) H/P

Pump Capacity (GPM) No. of Stages Setting Depth FT.

PUMP TEST

Well yielded \_\_\_\_\_ GPM with  
a drawdown of \_\_\_\_\_ ft.  
after \_\_\_\_\_ hours of pumping

WELL DATA

Well Depth	Casing Diameter (In.) <u>16</u>	Casing Length (Ft.)
Type of Casing <u>pvc</u>	Hole Depth	Depth to Static Water Level <u>22</u>

TYPE OF COMPLETION: (Circle One or More):  
Gravel Packed Underreamed, Telescoped,  
Natural Development, Open Hole, Other

(Describe) Hole plug

Top of Lap Pipe or Reduction in Casing

FEET IF TELESCOPED OR MORE THAN ONE SCREEN: USE BACK PAGE

LOG DATA

TYPE OF LOG RUN (Circle One): No Log Run  
Electric, Gamma Ray, Density, Sonic, Neutron,  
Other (Describe)

Name of Organization Running Log

SCREEN DATA

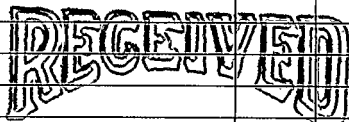
Diameter - Inches <u>16</u>	Length - Feet <u>40</u>	Slot Size - Inches <u>.050</u>
Screen Type <u>pvc</u>	Depth to Bottom - Feet	

GEOLOGIC DATA (Office Use Only)

Surface Elev.	Geologic Unit	Unit Thickness	Depth to Top
Subs. SWL	Date	Analysis	Aquifer Test

Driller's Remarks

DESCRIPTION OF FORMATIONS ENCOUNTERED	FROM	TO
<u>Clay</u>	<u>0</u>	<u>22</u>
<u>Sand</u>	<u>22</u>	<u>31</u>
<u>NE + gravel</u>	<u>31</u>	<u>90</u>

FORMATIONS (Continued)	FROM	TO
 AUG 11 1992 Dept. of Environmental Quality Bureau of Land & Water Resources		
IF MORE SPACE IS NEEDED, USE BACK		

If well telescopes please  
sketch and show depths.

GROUND LEVEL

		X	

SECTION 26

Please indicate well location X.

ADDITIONAL INFORMATION

If more than one screen,  
show location of each on sketch.