

MISSISSIPPI DEPARTMENT OF ENVIRONMENTAL QUALITY

Office of Land and Water Resources

P. O. Box 10631
Jackson, MS 39289-0631
WATER WELL DRILLERS LOG

COUNTY WELL LOCATED
Washington

WELL NUMBER *M* CODED

2034

DATE WELL COMPLETED
6-28-95

PERMIT NUMBER

NAME OF DRILLING FIRM
Schudco Ltd

NAME & MAILING ADDRESS OF LANDOWNER
American Aqua Farms

4088 Hwy. 12

Hollandale, MS

WELL LOCATION: SEC *34* TOWNSHIP *16* RANGE *5*

DISTANCE *7* Miles DIRECTION *East* of NEAREST TOWN *Hollandale*

OTHER LANDMARK

WELL PURPOSE: Home, Irrigation, Municipal, Industrial Fish Pond etc.
Replacement well

PUMP DATA

PUMP TYPE (Circle One):
submersible, Turbine, Jet, Flowing Well,
Other (Describe)

POWER TYPE (Circle One):
Electric, Tractor, Diesel, Gasoline, Butane,
Other (Describe) H/P *20*

Pump Capacity (GPM) *1000* No. of Stages *1* Setting Depth *78* FT.

PUMP TEST

Well yielded _____ GPM with
a drawdown of _____ ft.
after _____ hours of pumping

WELL DATA

Well Depth <i>120</i>	Casing Diameter (In.) <i>10</i>	Casing Length (Ft.) <i>80</i>
Type of Casing <i>pvc</i>	Hole Depth <i>120</i>	Depth to Static Water Level <i>27</i>

LOG DATA

TYPE OF LOG RUN (Circle One):
Electric, Gamma Ray, Density, Sonic, No Log Run, Neutron,
Other (Describe)

Name of Organization Running Log

TYPE OF COMPLETION: (Circle One or More):
Gravel Packed, Underreamed, Telescoped,
Natural Development, Open Hole, Other

GEOLOGIC DATA (Office Use Only)

Surface Elev.	Geologic Unit	Unit Thickness	Depth to Top
Subs. SWL	Date	Analysis	Aquifer Test

WELL GROUTED TO A DEPTH OF *10* FEET
Type Grout (circle one): Cement, Bentonite, or Mix

Driller's Remarks

SCREEN DATA

Diameter - Inches <i>10</i>	Length - Feet <i>40</i>	Slot Size - Inches <i>.032</i>
Screen Type <i>pvc</i>	Depth to Bottom - Feet <i>120</i>	

DESCRIPTION OF FORMATIONS ENCOUNTERED	FROM	TO	FORMATION(S) CONTAINED FROM	TO
<i>clay</i>	<i>0</i>	<i>38</i>		
<i>sand + gravel</i>	<i>38</i>	<i>120</i>		


JAN 23 1996

Dept. of Environmental Quality
Office of Land & Water Resources

IF MORE SPACE IS NEEDED, USE BACK

If well telescopes please sketch and show depths.

GROUND LEVEL

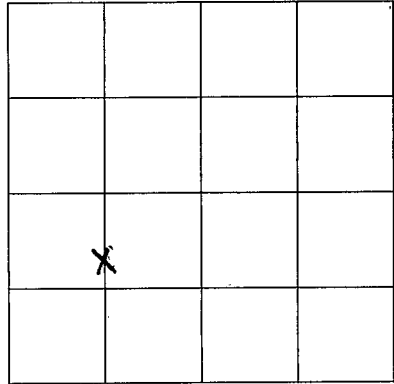

SECTION 34

Please indicate well location X.

ADDITIONAL INFORMATION

If more than one screen,
show location of each on sketch.