

MISSISSIPPI DEPARTMENT OF ENVIRONMENTAL QUALITY

Office of Land and Water Resources

P. O. Box 10631
Jackson, MS 39289-0631
WATER WELL DRILLERS LOG

COUNTY WELL LOCATED Washington
WELL NUMBER M
DATE WELL COMPLETED 4-19-95

PERMIT NUMBER
NAME OF DRILLING FIRM Schudco, Ltd.

NAME & MAILING ADDRESS OF LANDOWNER John Dillard			
Rt 1 Box 251			
Leland, MS			
WELL LOCATION: SEC	TOWNSHIP	RANGE	
9	16^N_S	6^E_W	
DISTANCE	DIRECTION	NEAREST TOWN	
4 Miles	SE	of Arcola	
OTHER LANDMARK			
WELL PURPOSE: Home, Irrigation, Municipal, Industrial, <u>Fish Pond</u> , etc.			

PUMP DATA		
PUMP TYPE (Circle One): Submersible, <u>Turbine</u> , Jet, Flowing Well, Other (Describe)		
POWER TYPE (Circle One): <u>Electric</u> , Tractor, Diesel, Gasoline, Butane, Other (Describe) H/P 50		
Pump Capacity (GPM) 2500	No. of Stages 1	Setting Depth 60 FT.
PUMP TEST		
Well yielded _____ GPM with a drawdown of _____ ft. after _____ hours of pumping		

WELL DATA		
Well Depth 130'	Casing Diameter (In.) 16"	Casing Length (Ft.) 90'
Type of Casing PVC	Hole Depth 130'	Depth to Static Water Level 30'
TYPE OF COMPLETION: (Circle One or More): <u>Gravel Packed</u> , Underreamed, Telescoped, Natural Development, Open Hole, Other		
WELL GROUTED TO A DEPTH OF 10 FEET Type Grout (circle one): Cement, <u>Bentonite</u> , or Mix		

LOG DATA	
TYPE OF LOG RUN (Circle One): Electric, Gamma Ray, Density, Sonic, <u>No Log Run</u> , Other (Describe)	
Name of Organization Running Log	


SCREEN DATA		
Diameter - Inches 16"	Length - Feet 40'	Slot Size - Inches .032
Screen Type PVC	Depth to Bottom - Feet 130'	

GEOLOGIC DATA (Office Use Only)			
Surface Elev.	Geologic Unit	Unit Thickness	Depth to Top
Subs. SWL	Date	Analysis	Aquifer Test
Driller's Remarks			

DESCRIPTION OF FORMATIONS ENCOUNTERED	FROM	TO	FORMATIONS (continued)	FROM	TO
Topsoil	0	15	DRILLING	15	130
Sand & gravel	15	130			
			JAN 16 1996		
			Dept. of Environmental Quality Office of Land & Water Resources		
			IF MORE SPACE IS NEEDED, USE BACK		

If well telescopes please sketch and show depths.

GROUND LEVEL

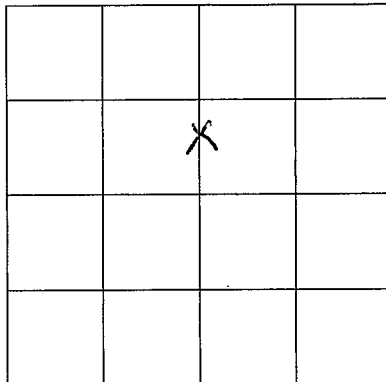

SECTION

9

Please indicate well location X.

ADDITIONAL INFORMATION

If more than one screen,
show location of each on sketch.