

MISSISSIPPI DEPARTMENT OF ENVIRONMENTAL QUALITY

Office of Land and Water Resources

P. O. Box 10631
Jackson, MS 39289-0631
WATER WELL DRILLERS LOG

COUNTY WELL LOCATED Washington	
WELL NUMBER M 2036	CODED
DATE WELL COMPLETED 6-1-96	

PERMIT NUMBER
NAME OF DRILLING FIRM Irrigation Equipment
Indianola, MS

NAME & MAILING ADDRESS OF LANDOWNER			
Hollandale Farms c/o American AG 525 Fairview Ave. Greenville, MS 38701			
WELL LOCATION:	SEC	TOWNSHIP	RANGE
	31	16N S	5W E
DISTANCE	DIRECTION	NEAREST TOWN	
6	East Miles	Hollandale of	
OTHER LANDMARK:			
WELL PURPOSE: Home, Irrigation, Municipal, Industrial, Fish Pond, etc. Irrigation.			

PUMP DATA		
PUMP TYPE (Circle One): Submersible, <u>Turbine</u> Jet Flowing Well, Other (Describe)		
POWER TYPE (Circle One): Electric, Tractor, <u>Diesel</u> Gasoline, Butane. Other (Describe) H/P 60		
Pump Capacity (GPM)	No. of Stages	Setting Depth
3000	1	60 FT.
PUMP TEST		
Well yielded _____ GPM with a drawdown of _____ ft. after _____ hours of pumping		

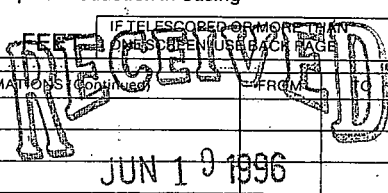
WELL DATA		
Well Depth	Casing Diameter (In.)	Casing Length (Ft.)
117	16	77
Type of Casing	Hole Depth	Depth to Static Water Level
PVC	117	25ft. est.
TYPE OF COMPLETION: (Circle One or More): <u>Gravel Packed</u> , Underreamed, Telescoped, Natural Development, Open Hole, Other (Describe)		
WELL GROUTED TO A DEPTH OF _____ FEET Type Grout (circle one): Cement, Bentonite, or Mix		

LOG DATA	
TYPE OF LOG RUN (Circle One): No Log Run, Electric, Gamma Ray, Density, Sonic, Neutron, Other (Describe)	
Name of Organization Running Log	

SCREEN DATA		
Diameter - Inches	Length - Feet	Slot Size - Inches
16	40	.032
Screen Type	Depth to Bottom - Feet	
PVC	117	

GEOLOGIC DATA (Office Use Only)			
Surface Elev.	Geologic Unit	Unit Thickness	Depth to Top
Subs. SWL	Date	Analysis	Aquifer Test

DESCRIPTION OF FORMATIONS ENCOUNTERED	FROM	TO
Clay	0	20
Fine Sand	20	60
Fine Sand & Gravel	60	71
Med. Sand & Gravel	71	117

Driller's Remarks
Top of Lap Pipe or Reduction in Casing

Dept. of Environmental Quality Office of Land & Water Resources
IF MORE SPACE IS NEEDED, USE BACK

If well telescopes please
sketch and show depths.

GROUND LEVEL

X			

SECTION 31

Please indicate well location X.

ADDITIONAL INFORMATION

If more than one screen,
show location of each on sketch.