


If well telescopes please sketch and show depths.

GROUND LEVEL

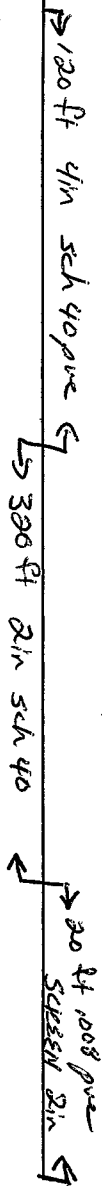

| | | | |
|---|--|--|--|
| | | | |
| | | | |
| X | | | |
| | | | |

SECTION 34

Please indicate well location X.

ADDITIONAL INFORMATION

If more than one screen, show location of each on sketch.