

MISSISSIPPI BOARD OF WATER COMMISSIONERS

Washington  
N 30  
5-66

WATER WELL DRILLERS LOG

Washington

Date: May 26, 1966, Driller: Butane Gas Co. County: Leflore  
(Name)

(1) Owner of Land: Bob Ainsworth  
(Name)  
Glen Allen, Miss.  
(Address)

(2) Location: NE 1/4, SE 1/4, Sec. 27 T 15 R W  
9 miles N-East, of Glen Allen  
(distance) (direction) (Nearest Town)

(3) Topography: Flat  
(Hilly) (Flat) (Level)

(4) Purpose of Well: Irrigation  
(Domestic Irrigation  
Municipal, Industrial, Other)

Description & Color of Materials Sand, Clay, Red Clay, Shell, etc.	Thick- ness Feet	Depth Feet
Clay	13	13
" "	10	23
Blue Clay	10	33
Blue Clay & fine sand	10	43
med. sand	10	53
med. sand, gravel, clay	10	63
sand + gravel	10	73
" "	10	83
" "	10	93
" "	10	103
" "	10	113

Information upon completion of well:

(1) Diameter 16 inches.

(2) Total Depth 113 feet.

(3) Water Level 16 feet below top of ground.

(4) Cased to 73, Size 16


(5) Screen: Size 16, Length 40

(6) Were any formations sealed against pollution?  
X yes, X no.

If YES depth of formation \_\_\_\_\_

Why \_\_\_\_\_

Drillers Remarks: \_\_\_\_\_

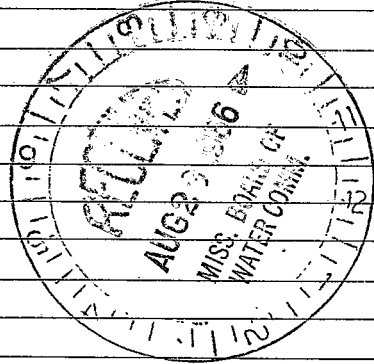

±112'

(Use Back Side)

Well No.

retain this copy for your office files.

