


Washington
 N37
 1-67

MISSISSIPPI
 BOARD OF WATER COMMISSIONERS
 416 North State Street
 Jackson, Mississippi 39201

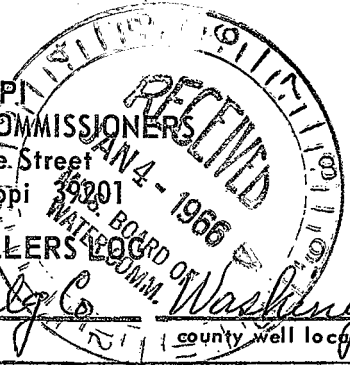

WATER WELL DRILLERS LOG

1/3 1967 Bailey Drilling Co. Washington
 date well completed firm name county well located

LANDOWNER: M H Reek & Son
 Chatham, Miss.

description of formations encountered	from to	
	feet	feet
Clay	0	82
Sand	82	160
Gravel	160	180
Mud	180	348
Sand	348	389
Mud	389	690
Rock	690	691
Mud	691	785
Sand	785	828

(mailing address)

WELL LOCATION:

sec. 18 T. 15 N. R. 8 W.
 0 miles S of Longwood
 (distance) (direction) (nearest town)

WELL PURPOSE: Home
 (home, irrigation, municipal, industrial)

WELL COMPLETION DATA:

- (1) diameter (inches) 4 x 3 x 2 1/2
- (2) total depth (feet) 828
- (3) static water level (feet) 28 below top of ground.
- (4) casing Black Steel pipe (material) (depth)
- (size) if telescope see back.
- (5) screen 30 ft 798 (length) (depth to top)
 2 1/2 Stainless Steel (size) (material)
- (6) pump 1 18 (HP) (yield gpm)
 Sub (type power)
- (7) electric log No (yes or no)

(organization running log)

(8) how well bottom plugged back pressure valve

DRILLERS REMARKS:

If well telescopes please sketch and show depths.

GROUND LEVEL

210 ft. of 4' Pipe

294 ft. r 3" ✓

294 ft. r 2½" ✓

30 ft. 2½" Screen
at bottom

X			

SECTION 18

Please indicate well location X.

ADDITIONAL INFORMATION

If more than one screen,
show locations of each on sketch.