

WASH.

N 41

3-23-64

WATER WELL DRILLERS LOG

CODED

Date: 3/23, 1964, Driller: Bailey Dig. Co. County Washington (Name)

(1) Owner of Land: Billy Joe Trotter
(Name)
Seland James, Miss.
(Address)

(2) Location: 1/4, 1/4, Sec 3 T. 8N R. 8W
4 miles S.E., of James
(distance) (direction) (Nearest Town)

(3) Topography: Flat
(Hilly) (Flat) (Level)

(4) Purpose of Well: Domestic
(Domestic Irrigation
Municipal, Industrial, Other)

Description & Color of Materials Sand, Clay, Red Clay, Shell, etc.	Thick- ness Feet	Depth Feet
Clay		15
Sand		85
Gravel		110
Mud		340
Sand		360
Mud		593
Rock		593 1/2
Mud		695
Sand		745
Mud		746

Information upon completion of well:

(1) Diameter 2 1/2 x 2 inches.

(2) Total Depth 739 feet.

(3) Water Level 20 feet below top of ground.

(4) Cased to All way, Size 2 1/2 x 2.

(5) Screen: Size 2", Length 15 ft.

(6) Were any formations sealed against pollution?
no yes, X no.


CODED

Insuff. info. to locate

If YES depth of formation _____

Why _____

Drillers Remarks: _____

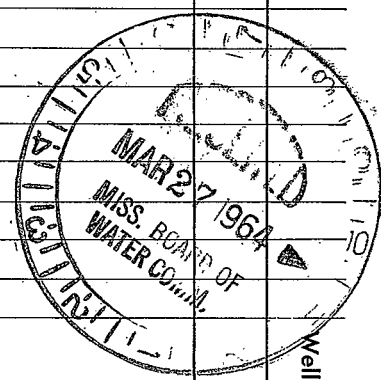

(Use Back Side)

Well No.

