

WASH.  
N 42  
3-22-61

WATER WELL DRILLERS LOG

CODED

Date: 3/22, 1961, Driller: Bailey Drilling Co. County: Washington  
(Name)

(1) Owner of Land: Geo. Stone  
(Name)  
Chatham, Miss.  
(Address)

(2) Location: 1/4, 1/4, Sec. 31 15 N 8 W T R  
2 miles East of Chatham  
(distance) (direction) (Nearest Town)

(3) Topography: Flat  
(Hilly) (Flat) (Level)

(4) Purpose of Well: Domestic  
(Domestic Irrigation  
Municipal, Industrial, Other)

Description & Color of Materials Sand, Clay, Red Clay, Shell, etc.	Thick- ness Feet	Depth Feet
Clay	18	18
Sand	42	60
Gravel + Sand	35	95
Mud	89	184
Sand + Mud	41	225
Sand	50	275
Mud	5	280
Sand	12	292
Mud	8	300
Sand	70	370
Mud	128	498
Rock CODED	1	499
Mud	37	536
Rock	1	537
Mud	8	545
Rock	1	546
Sand + Mud	48	594
Fine Sand	41	635
Sand	62	697
Mud	20	717
Mud + Sand	83	800
Sand	57	857

Information upon completion of well:

(1) Diameter: 2 1/2 X 2 inches.

(2) Total Depth: 857 feet.

(3) Water Level: 18 1/2 feet below top of ground.

(4) Cased to: all way, Size: 2 1/2 X 2


(5) Screen: Size 2", Length 20ft

(6) Were any formations sealed against pollution?  
 yes,  no.

If YES depth of formation \_\_\_\_\_

Why \_\_\_\_\_

Drillers' Remarks: \_\_\_\_\_

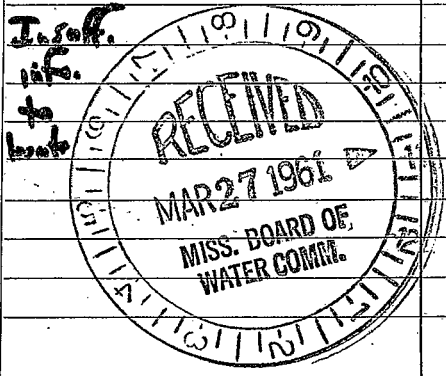

(Use Back Side)

Well No.

