

WASHINGTON  
N 45  
9-10-70

MISSISSIPPI  
BOARD OF WATER COMMISSIONERS  
416 North State Street  
Jackson, Mississippi 39201

**CODED**

WATER WELL DRILLERS LOG

Sep 10 1970 date well completed  
DYER WELL & IRRIGATION SERVICE firm name  
Washington county well located

LANDOWNER: John Cox  
GREENVILLE  
Miss.  
(mailing address)

description of formations encountered	from	to
Clay	0	13
Red Clay	13	23
Clay	23	33
Blue Clay	33	43
Blue Clay	43	53
S. Clay 5' Sand	53	63
Coarse Sand	63	73
Coarse Sand Ten Gravel	73	83
Fine Hard Sand	83	93

WELL LOCATION:  
sec. 15 T N R. 8 E  
3 1/2 miles E of Longway  
(distance) (direction) (nearest town)

WELL PURPOSE: FISH  
(home, irrigation, municipal, industrial)

- WELL COMPLETION DATA:
- (1) diameter (inches) 16"
  - (2) total depth (feet) 94
  - (3) static water level (feet) 15' below above top of ground.
  - (4) casing BURN 54'  
(material) (depth)  
16" if telescope see back.  
(size)
  - (5) screen 40' 54'  
(length) (depth to top)  
16" BURN  
(size) (material)
  - (6) pump 50 2500  
(HP) (yield gpm)  
ELEC  
(type power)
  - (7) electric log N  
(yes or no)
  - (organization running log)
  - (8) how well bottom plugged PLATE


**CODED**

DRILLERS REMARKS:

SEP 16 1970

If well telescopes please sketch and show depths.

GROUND LEVEL

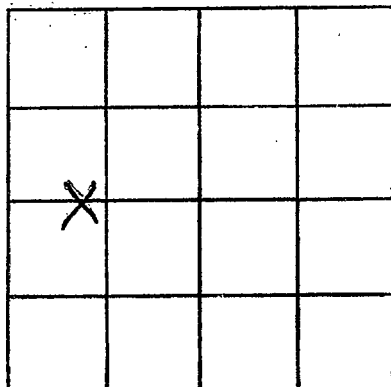

SECTION 21

Please indicate well location X.

ADDITIONAL INFORMATION

If more than one screen, show locations of each on sketch.