

Washington  
N-47  
9-3-71

MISSISSIPPI  
BOARD OF WATER COMMISSIONERS  
416 North State Street  
Jackson, Mississippi 39201

**CODED**

WATER WELL DRILLERS LOG

9/3 1971 Bailey Drilling Co Washington  
date well completed firm name county well located

LANDOWNER: Lloyd McMahon

description of formations encountered

Hollandale

from to

Miss.

(mailing address)

WELL LOCATION:

sec. 3 T. 15 R. 8  
5 miles W of Hollandale  
(distance) (direction) (nearest town)

WELL PURPOSE: Home  
(home, irrigation, municipal, industrial)

WELL COMPLETION DATA:

(1) diameter (inches) 4 X 2

(2) total depth (feet) 1125

(3) static water level (feet) 28 below above top of ground.

(4) casing steel, 1115  
(material) (depth)

4 X 2 If telescope see back.  
(size)

(5) screen 20', 1115'  
(length) (depth to top)

2" stainless steel  
(size) (material)

(6) pump 3/4 12  
(HP) (yield gpm)

Elec  
(type power)

(7) electric log no  
(yes or no)

(organization running log)

(8) how well bottom plugged back pressure valve

DRILLERS REMARKS:

description of formations encountered	from	to
Clay	0	20
Sand	20	60
Mud	60	90
Gravel	90	115
Mud	115	300
Sand	300	490
Mud	490	800
Fine sand + Mud	800	900
Mud	900	950
Rock	950	951
Mud	951	998
Rock	998	999
Mud	999	1008
Rock	1008	1009
Mud	1009	1070
Rock	1070	1071
Mud	1071	1079
Rock	1079	1081
Fine sand	1081	1085
Mon. in field	1085	1135

**CODED**

SEP 7 1971

MISS. BD. OF  
WATER COMM.

If well telescopes please sketch and show depths.


GROUND LEVEL

147' 11"

84' 2 1/2"

854' 2"

20' 2" Strainer

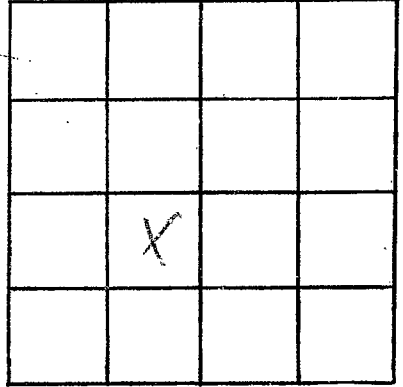

SECTION 27

Please indicate well location X.

ADDITIONAL INFORMATION

If more than one screen, show locations of each on sketch.