

Washington
N48
5-19-71

MISSISSIPPI
BOARD OF WATER COMMISSIONERS
416 North State Street
Jackson, Mississippi 39201

WATER WELL DRILLERS LOG
DYER WELL & IRRIGATION SERVICE

CODED

WASHINGTON

5-19-71
date well completed

firm name

county well located

LANDOWNER:
ALBERT PREUBT
HOLLANDALE MISS.
(mailing address)

description of formations encountered	from	to
CLAY	0	23
CLAY (RED)	23	30
RED CLAY & FINE SAND	30	44
FINE SAND	44	70
SAND (MED)	70	85
CLAY	86	90

WELL LOCATION:
sec. 27 T 15 N R 8 E
2 miles NE of ERWIN
(distance) (direction) (nearest town)

WELL PURPOSE: FISH
(home, irrigation, municipal, industrial)

- WELL COMPLETION DATA:
- (1) diameter (inches) 16"
 - (2) total depth (feet) 90'
 - (3) static water level (feet) 28' below top of ground.
 - (4) casing B&I, SOFT
(material) (depth)
16" if telescope see back.
(size)
 - (5) screen 40' 50'
(length) (depth to top)
16" B&I, INGOT
(size) (material)
 - (6) pump 25 1250
(HP) (yield gpm)
ELEC
(type power)
 - (7) electric log N/O
(yes or no)
 - (organization running log)
 - (8) how well bottom plugged B.P.H.
PLATE


CODED

OCT 26 1971

DRILLERS REMARKS:

If well telescopes please sketch and show depths.

GROUND LEVEL

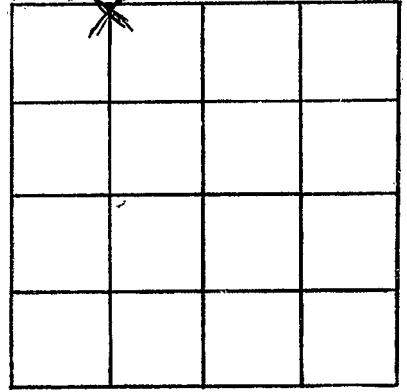

SECTION 27

Please indicate well location X.

ADDITIONAL INFORMATION

If more than one screen,
show locations of each on sketch.