

WASHINGTON
N 50
5-22-72

MISSISSIPPI
BOARD OF WATER COMMISSIONERS
416 North State Street
Jackson, Mississippi 39201

CODED

WATER WELL DRILLERS LOG

5-22 1972 Bailey Drilling Co. Washington
date well completed firm name county well located

LANDOWNER: H. L. Wade
Glen Allen Chatham
Miss
(mailing address)

description of formations encountered	from	to
	0	30
Clay	30	85
Sand	85	112
Gravel	112	300
Mud	300	420
Sand	420	540
Mud	540	680
Mud + Sand	680	797
Sand		

WELL LOCATION:
sec. 13 T. 15 N R. 9 W
5 miles N of Glen Allen
(distance) (direction) (nearest town)

WELL PURPOSE: Home
(home, irrigation, municipal, industrial)

- WELL COMPLETION DATA:
- (1) diameter (inches) 4 X 2
 - (2) total depth (feet) 797
 - (3) static water level (feet) 30' below above top of ground.
 - (4) casing Steel, 782,
(material) (depth)
4 X 2 if telescope see back.
(size)
 - (5) screen 15', 782
(length) (depth to top)
2", Stainless Steel
(size) (material)
 - (6) pump 1, 20
(HP) (yield gpm)
Elec
(type power)
 - (7) electric log No
(yes or no)
- (organization running log)

CODED

MAY 24 1972

MISS. BD. OF
WATER COMMISSIONERS

(8) how well bottom plugged:
Back pressure valve

DRILLERS REMARKS:


If well telescopes please sketch and show depths.

GROUND LEVEL

145' 4

6.35' 2'

15' 5" in over

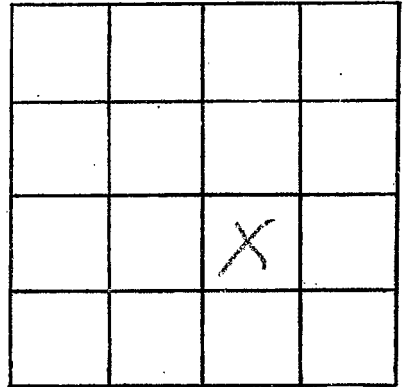

SECTION _____

Please indicate well location X.

ADDITIONAL INFORMATION

If more than one screen, show locations of each on sketch.