

MISSISSIPPI
BOARD OF WATER COMMISSIONERS
416 North State Street
Jackson, Mississippi 39201

CODED

WATER WELL DRILLERS LOG

WASH
N52
10-23-73
log # 82
CCJ 23 19 73 Delta Drilling

date well completed

firm name

county well located

LANDOWNER: MR. C. G. STEELE

description of formations encountered

from

to

Ref. 1
HOLLIDALE 38748
(mailing address)

top soil	0	17
sand	17	65
GRAVEL	65	143
gumbo	143	208
sand	208	292
gumbo	292	307
sand	307	394
gumbo	394	457
sand	457	515
gumbo	515	528
sand	528	547
gumbo	547	555
CLAY	555	603
sand	603	617
gumbo	617	623
sand	623	646
some silty clay	646	662
sand	662	776
gumbo	776	790
Rock 9"	790	829
gumbo/sand	829	851
gumbo	851	865
sand	865	877
Rock 2"	877	877
sand	877	916
gumbo	916	918

WELL LOCATION:

sec. 17 T 15 N S R 8 E

(distance) miles (direction) of (nearest town)

WELL PURPOSE:
(home, irrigation, municipal, industrial)

WELL COMPLETION DATA:

- (1) diameter (inches) 4 X 2
- (2) total depth (feet) 761
- (3) static water level (feet) _____ below top of ground.
- (4) casing steel 761 (material) (depth)
- _____ if telescope see back. (size)
- (5) screen 20' 741 (length) (depth to top)
2" 35 (size) (material)
- (6) pump 1 1/2 35 (HP) (yield gpm)
- ELEC. (type power)
- (7) electric log _____ (yes or no)
State (organization running log)



(8) how well bottom plugged
BACK PRESSURE VALVE

DRILLERS REMARKS:

UGI 25 11/73

If well telescopes please sketch and show depths.

GROUND LEVEL

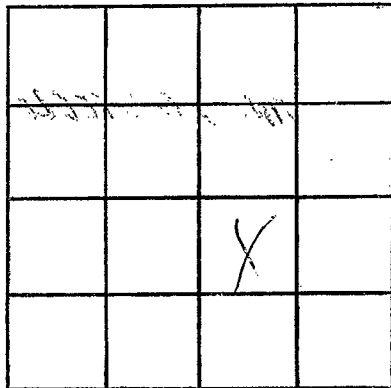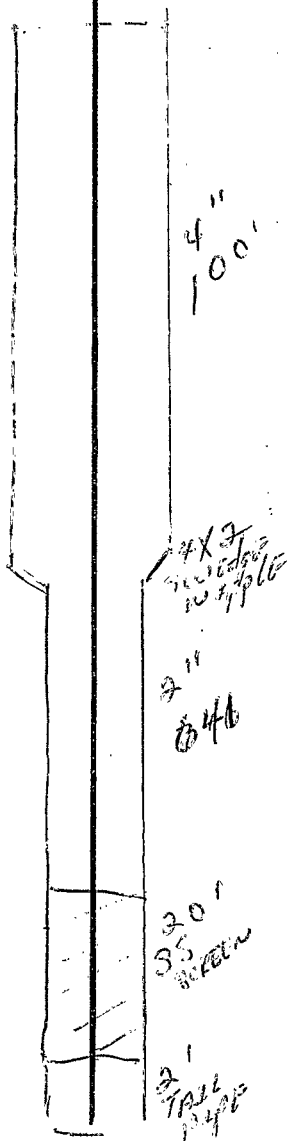

SECTION _____

Please indicate well location X.

ADDITIONAL INFORMATION

A series of horizontal lines for additional information, starting below the "ADDITIONAL INFORMATION" header and extending to the bottom of the page.

If more than one screen, show locations of each on sketch.