

CODED

MISSISSIPPI  
BOARD OF WATER COMMISSIONERS  
416 North State Street  
Jackson, Mississippi 39201

WATER WELL DRILLERS LOG

WASH  
N 54  
3-12-74

3/12 1974 Bailey Drilling Co Washington  
date well completed firm name county well located

LANDOWNER: Billy Prother  
Hollandale  
Miss.  
(mailing address)

WELL LOCATION:  
sec. 4 T. 15 N. R. 8 E  
S W  
4 miles east of James  
(distance) (direction) (nearest town)

WELL PURPOSE: Farm  
(home, irrigation, municipal, industrial)

WELL COMPLETION DATA:

- (1) diameter (inches) 4X2
- (2) total depth (feet) 575
- (3) static water level (feet) \_\_\_\_\_ below  
top of ground. above
- (4) casing Steel, 505,  
(material) (depth)  
4X2 if telescope see back.  
(size)
- (5) screen 10ft, 505  
(length) (depth to top)  
2", Stainless Steel  
(size) (material)
- (6) pump \_\_\_\_\_ 19  
(HP) (yield gpm)  
Electric  
(type power)
- (7) electric log No  
(yes or no)


\_\_\_\_\_  
(organization running log)

(8) how well bottom plugged  
back pressure valve

DRILLERS REMARKS:

description of formations encountered	from	to
Clay	0	10
Sand	10	80
Gravel	80	110
Mud	110	260
Mud + Sand	260	300
Mud	300	405
Sand	405	410
Mud	410	495
Sand	495	500
Hard place	500	501
Sand	501	575

CODED

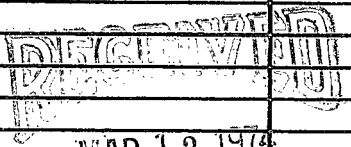

MAR 13 1974

MISS. BD. OF WATER COMMISSIONERS

