

WASH.  
N 55  
3-15-74

MISSISSIPPI  
BOARD OF WATER COMMISSIONERS  
416 North State Street  
Jackson, Mississippi 39201

CODED

WATER WELL DRILLERS LOG

15 mar 1974 Lambert Drilling Wash  
date well completed firm name county well located


LANDOWNER:  
Geo. Stone  
Chatham, Miss.  
(mailing address)

WELL LOCATION:  
sec. 12 T. 15 N. R. 9 E  
2 miles N of Chatham  
(distance) (direction) (nearest town)

WELL PURPOSE: none  
(home, irrigation, municipal, industrial)

WELL COMPLETION DATA:  
(1) diameter (inches) 4x2  
(2) total depth (feet) 820  
(3) static water level (feet) 28 below top of ground.  
(4) casing Steel, 800, (material) (depth)  
4x2 (size) if telescope see back.  
(5) screen 20', stainless steel (length) (depth to top)  
2" (size), 820-800 (material)  
(6) pump 1 (HP), 25 (yield gpm)  
ELECT (type power)  
(7) electric log (yes or no)  
(organization running log)  
(8) how well bottom plugged back wash

description of formations encountered	from	to
Mixed	0	30
Sand	30	86
Fine pore gravel	86	185
Sand st. clay	185	580
Shell	580	620
Clay	620	656
ROCK	656	659
Sand & clay st.	659	756
Sand med.	756	780
Sand good	780	830

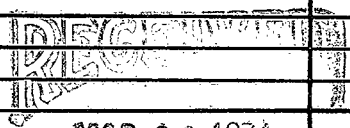

MAR 20 1974

DRILLERS REMARKS:

