

WASH.
N56
3-10-74


MISSISSIPPI
BOARD OF WATER COMMISSIONERS
416 North State Street
Jackson, Mississippi 39201

CODED

WATER WELL DRILLERS LOG

10 Mar 1974 Lambert Drilling Co Wash
date well completed firm name county well located

LANDOWNER:	description of formations encountered	from	to
Stone Bros. Chatham, Miss. (mailing address)			
WELL LOCATION: sec. 32 T. 15 N. R. 8 W. 2.8 miles S of Greenville (distance) (direction) (nearest town)	Sands	80	80
WELL PURPOSE: home (home, irrigation, municipal, industrial)	Fine pea gravel	80	170
WELL COMPLETION DATA: (1) diameter (inches) 4x2 (2) total depth (feet) 840 (3) static water level (feet) 28 below top of ground. (4) casing Steel 820 (material) (depth) 4x2 (size) if telescope see back. (5) screen 20 840-820 (length) (depth to top) 2" SS (size) (material) (6) pump 1 25 (HP) (yield gpm) Elect (type power) (7) electric log (yes or no) (organization running log) (8) how well bottom plugged: back Wash	Sand	110	140
	Clay CODED	140	180
	Sand & clay st.	180	465
	Sand Pine	465	590
	Shell	590	650
	Sand & clay	650	668
	Rock	668	670
	Clay	670	729
	Sand & clay st.	729	770
	Sand med.	770	810
	Sand good	810	840
DRILLERS REMARKS:			

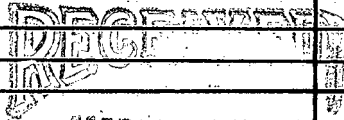

MISS. Bd. of Water Comm.

If well telescopes please sketch and show depths.

GROUND LEVEL

126

411

694

211

20

55

	X		

SECTION 32

Please indicate well location X.

ADDITIONAL INFORMATION

If more than one screen,
show locations of each on sketch.