

WASHINGTON
N57
3-25-74

MISSISSIPPI
BOARD OF WATER COMMISSIONERS
416 North State Street
Jackson, Mississippi 39201

CODED


WATER WELL DRILLERS LOG

March 25, 1974 Singer-Layne Central Div. Washington
date well completed firm name county well located

LANDOWNER:	description of fomations encountered	from	to
Elmon Thomas			
Hollandale, Mississippi (mailing address)	Sand	14	30
	Coarse Sand & Pea Gravel	30	60
	Coarse Sand Gravel	60	102
	Pink Clay	102	---
WELL LOCATION:			
sec 12 T 15 N R 8			
5 miles West of Hollandale (distance) (direction) (nearest town)			
WELL PURPOSE: Irrigation (home, irrigation, municipal, industrial)			
WELL COMPLETION DATA:			
(1) diameter (inches) 16"	CODED		
(2) total depth (feet) 102'			
(3) static water level (feet) 11' below top of ground.			
(4) casing Steel 52' (material) (depth)			
16" if telescope see back. (size)			
(5) screen 50' 102' (length) (depth to top)			
16" Steel (size) (material)			
(6) pump 60 2000 (HP) (yield gpm)			
Engine (type power)			
(7) electric log No (yes or no)			
(organization running log)			
(8) how well bottom plugged Plate			
DRILLERS REMARKS:			
APR 24 1974			

If well telescopes please sketch and show depths.

GROUND LEVEL

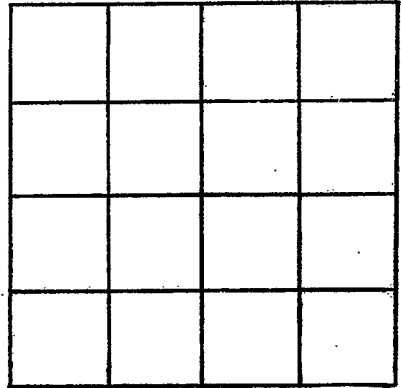

SECTION _____

Please indicate well location X.

ADDITIONAL INFORMATION

If more than one screen, show locations of each on sketch.