

WASHINGTON
N 58
3-25-74

MISSISSIPPI
BOARD OF WATER COMMISSIONERS
416 North State Street
Jackson, Mississippi 39201

CODED

WATER WELL DRILLERS LOG

March 25, 19 74 Singer-Layne Central Div. Washington
date well completed firm name county well located

LANDOWNER:	description of formations encountered	from	to
Elmon Thomas			
Hollandale, Mississippi (mailing address)	Clay	0	13
	Sand	13	48
	Clay	48	58
WELL LOCATION: sec 12 T 15 N R 8 E 5 miles West of Hollandale (distance) (direction) (nearest town)	Sand and Gravel	58	101
	Pink Clay	101	---
WELL PURPOSE: Irrigation (home, irrigation, municipal, industrial)			
WELL COMPLETION DATA:			
(1) diameter (inches) 16"			
(2) total depth (feet) 101'			
(3) static water level (feet) 10' below top of ground.			
(4) casing Steel 61' (material) (depth)			
16" if telescope see back. (size)			
(5) screen 40' 101' (length) (depth to top)			
16" Steel (size) (material)			
(6) pump 60 1800 (HP) (yield gpm)			
Engine (type power)			
(7) electric log No (yes or no)			
(organization running log)			
(8) how well bottom plugged Plate			
DRILLERS REMARKS:			


CODED

APR 9 1974

MISS. BD. OF WATER CONTROL

If well telescopes please sketch and show depths.

GROUND LEVEL

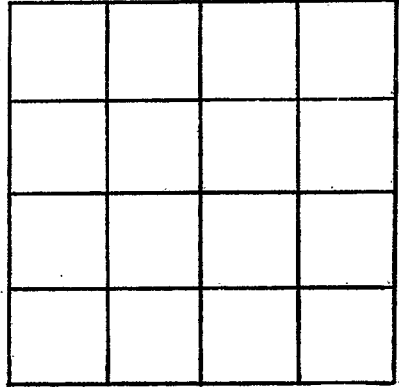

SECTION _____

Please indicate well location X.

ADDITIONAL INFORMATION

If more than one screen, show locations of each on sketch.