

**WASHINGTON**  
**N 59**  
**6-12-74**

MISSISSIPPI  
 BOARD OF WATER COMMISSIONERS CODED  
 416 North State Street  
 Jackson, Mississippi 39201  
**WATER WELL DRILLERS LOG**


June 12, 1974 Singer-Layne Central Div Washington  
 date well completed firm name county well located

LANDOWNER:	description of formations encountered	from	to
C. G. Steele			
Hollandale, Mississippi (mailing address)	Sand with Some Clay & Gravel	40	89
WELL LOCATION:	Clay	89	
sec. 12 T. 15 N. R. 8 W			
miles of Longwood (distance) (direction) (nearest town)			
WELL PURPOSE: Irrigation (home, irrigation, municipal, industrial)			
WELL COMPLETION DATA:			
(1) diameter (inches) 16"			
(2) total depth (feet) 89'			
(3) static water level (feet) 11 below top of ground.			
(4) casing Steel, 49' (material), (depth) 16" (size) if telescope see back.			
(5) screen 40' (length), 89' (depth to top) 16" (size), Armco Iron (material)			
(6) pump 30 (HP), 1500 (yield gpm) Electric (type power)			
(7) electric log No (yes or no)			
(organization running log)			
(8) how well bottom plugged With Plate			
DRILLERS REMARKS:			

RECEIVED  
 SEP 23 1974

If well telescopes please sketch and show depths.

GROUND LEVEL

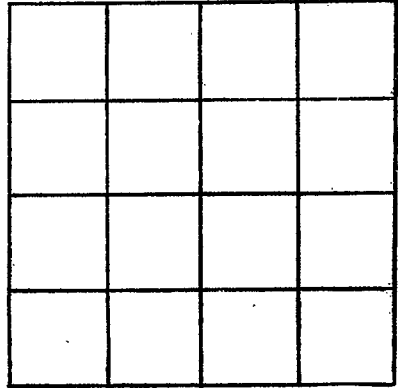

SECTION \_\_\_\_\_

Please indicate well location X.

ADDITIONAL INFORMATION

If more than one screen, show locations of each on sketch.