

WASH.
N 60
9-6-74

MISSISSIPPI
BOARD OF WATER COMMISSIONERS
416 North State Street
Jackson, Mississippi 39201

WATER WELL DRILLERS LOG

CODED

SEPT 6, 74 DYER WELL & IRRIGATION SERVICE WASHINGTON
date well completed firm name county well located

LANDOWNER:	description of formations encountered	from	to
LEO WILLIAMS #1	CLAY	0	27
HOLLANDALE, MISS - (mailing address)	COARSE SAND PEA ROCK + GRAVEL	27	98

WELL LOCATION:
sec. 10 T. 15 N. R. 8 E. W. 3
3 miles NE. of Lumberton
(distance) (direction) (nearest town)

WELL PURPOSE: IRR.
(home, irrigation, municipal, industrial)


- WELL COMPLETION DATA:
- (1) diameter (inches) 16"
 - (2) total depth (feet) 98
 - (3) static water level (feet) 16' below above top of ground.
 - (4) casing BUX IN, (material), (depth) _____
if telescope see back.
(size)
 - (5) screen 16" 58'
(length) (depth to top)
16" BUX IN GOT
(size) (material)
 - (6) pump 60 3000
(HP) (yield gpm)
DIESEL
(type power)
 - (7) electric log N/A
(yes or no)
(organization running log)
 - (8) how well bottom plugged PLATE

RECEIVED
NOV 21 1974

DRILLERS REMARKS:

If well telescopes please sketch and show depths.

GROUND LEVEL

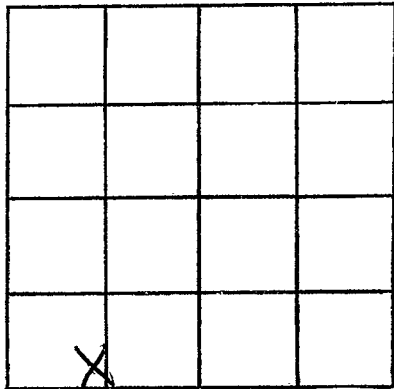

SECTION 10

Please indicate well location X.

ADDITIONAL INFORMATION

If more than one screen, show locations of each on sketch.