

**MISSISSIPPI  
BOARD OF WATER COMMISSIONERS**  
416 North State Street  
Jackson, Mississippi 39201

**WATER WELL DRILLERS LOG**

**CODED**

**WASH.**  
**NGI**  
**9-9-74**

**SEPT 9, 1974** DATE WELL COMPLETED      **OVER WELL & IRRIGATION SERVICE** FIRM NAME      **WASHINGTON** COUNTY WELL LOCATED

**LANDOWNER:**  
**LEO WILLIAMS #2**  
**HOLLANDALE, MISS.**  
(mailing address)

description of formations encountered	from	to
CLAY	17	25
FINE SAND	25	31
COARSE SAND +	31	
PEA GRADE		44
COARSE SAND PEB	44	
RACT GRAVEL		100

**WELL LOCATION:**  
sec. 10 T. 15 N. R. 8 W.  
3 miles N.E. of LONGWOOD  
(distance) (direction) (nearest town)

**WELL PURPOSE:** TRR.  
(home, irrigation, municipal, industrial)

**WELL COMPLETION DATA:**

- (1) diameter (inches) 16"
- (2) total depth (feet) 100'
- (3) static water level (feet) 16' below top of ground.
- (4) casing BUR IR 60'  
(material) (depth)  
16" if telescope see back.  
(size)
- (5) screen 40' 60'  
(length) (depth to top)  
16" BUR IN CO  
(size) (material)
- (6) pump leo 3000  
(HP) (yield gpm)  
DESIGN  
(type power)
- (7) electric log No  
(yes or no)

**CODED**

(organization running log)  
(8) how well bottom plugged PROB




**NOV 21 1974**

**DRILLERS REMARKS:**

If well telescopes please  
sketch and show depths.

GROUND LEVEL

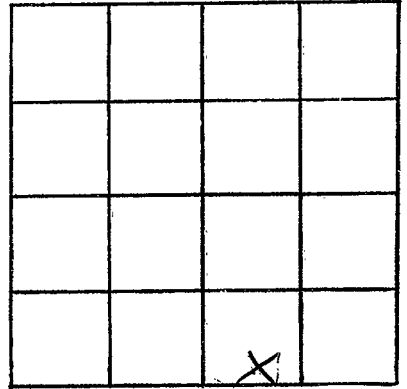

SECTION 1D

Please indicate well location X.

ADDITIONAL INFORMATION

If more than one screen,  
show locations of each on sketch.