

Washington
N 64°
5-3-75

MISSISSIPPI
BOARD OF WATER COMMISSIONERS
416 North State Street
Jackson, Mississippi 39201

CODED

WATER WELL DRILLERS LOG

Singer - Rayne


May 3, 19 75 Longwood Farm Washington
date well completed firm name county well located

LANDOWNER: Longwood Farms Rt. 1, Hollandale, Miss. (mailing address)	description of formations encountered	from	to
	Coarse Sand	65	72'
	Coarse Sand & Gravel	72	101'
WELL LOCATION: sec. 18 T 15 N R 8 E 151 X W 1 miles East of Longwood (distance) (direction) (nearest town)			
WELL PURPOSE: irrigation (home, irrigation, municipal, industrial)			
WELL COMPLETION DATA:			
(1) diameter (inches) 16"			
(2) total depth (feet) 101'			
(3) static water level (feet) 8 below top of ground.			
(4) casing Steel, 61' (material), (depth) 16" (size) if telescope see back.			
(5) screen 40' (length), 40' (depth to top) 16" (size), Steel (material)			
(6) pump 40 (HP), 1600-2200 (yield gpm) engine (type power)			
(7) electric log no (yes or no) (organization running log)			
(8) how well bottom plugged steel plate			
DRILLERS REMARKS:			

RECEIVED
MAY 14 1975

If well telescopes please sketch and show depths.

GROUND LEVEL

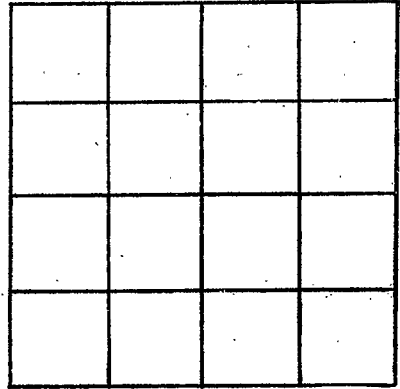

SECTION _____

Please indicate well location X.

ADDITIONAL INFORMATION

If more than one screen, show locations of each on sketch.