

Washington
N 65
9-29-75

MISSISSIPPI
BOARD OF WATER COMMISSIONERS
416 North State Street
Jackson, Mississippi 39201

COLED

WATER WELL DRILLERS LOG


Sept. 29 19 75 Bruce Berryman Washington
date well completed firm name county well located
Greenwood, Miss.

LANDOWNER: John H. Cox.	description of formations encountered	from	to
Mt. Holly Plantation,	Clay	0	20
P.O. Box 855, Greenville, Miss. 38701	Sand	20	80
(mailing address)	Sand & Gravel	80	100
WELL LOCATION:	Clay	100	220
sec. 32 T 15 N R 8 E 151	Sand	220	240
5 miles N of GLEN ALLEN	Sand & Str. Clay	240	260
(distance) (direction) (nearest town)	Sand	260	320
WELL PURPOSE: Home	Clay	320	380
(home, irrigation, municipal, industrial)	Shale	380	540
WELL COMPLETION DATA:	Fine sand	540	580
(1) diameter (inches) 4" x 2"	Clay	580	630
(2) total depth (feet) 818ft.	Sand	630	650
(3) static water level (feet) 20' below top of ground	Clay	650	660
blk pipe - 105'	Sandy shale	660	700
(4) casing 2" galv. - 692'	Sand	700	830
(material) (depth)			
(size) if telescope see back.			
(5) screen 20' 798'			
(length) (depth to top)			
2" .010 stainless steel			
(size) (material)			
(6) pump 1 1/2 h.p. 30 gpm			
(HP) (yield gpm)			
electric			
(type power)			
(7) electric log No			
(yes or no)			
(organization running log)			
(8) how well bottom plugged B.P.V.			
DRILLERS REMARKS:			

DRILLER'S SIGNATURE
NOV 4 1975
MISS. Bd. OF WATER COMM.

If well telescopes please sketch and show depths.

GROUND LEVEL

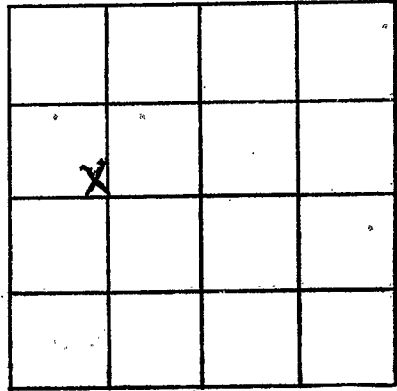

SECTION 32

Please indicate well location X.

ADDITIONAL INFORMATION

If more than one screen,
show locations of each on sketch.