

WASHINGTON

N 66

2/14/78

MISSISSIPPI BOARD OF WATER COMMISSIONERS
416 North State Street
Jackson, Mississippi 39201

CODED

WATER WELL DRILLERS LOG
BUTANE GAS COMPANY

WASHINGTON
county well located

2/14/78
date well completed

OF GREENWOOD
town name

LANDOWNER:	description of formations encountered	from	to
LONGWOOD FARMS			
HOLLANDALE (mailing address)	Clay SAND SAND & GRAVEL	0 15 50	15 50 116
WELL LOCATION:			
sec. <u>12</u> T. <u>15</u> N R. <u>8</u> W			
<u>7</u> miles <u>W</u> of <u>HOLLANDALE</u> (distance) (direction) (nearest town)			
WELL PURPOSE: <u>DR</u> (home, irrigation, municipal, industrial)			
WELL COMPLETION DATA:			
(1) diameter (inches) <u>16</u>			
(2) total depth (feet) <u>116</u>			
(3) static water level (feet) <u>17</u> below above top of ground.			
(4) casing <u>Steel</u> , <u>76</u> , (material) (depth) <u>16</u> " if telescope see back. (size)			
(5) screen <u>40</u> , <u>76</u> , (length) (depth to top) <u>16</u> " <u>Steel</u> (size) (material)			
(6) pump <u>40</u> <u>1800</u> (HP) (yield gpm) <u>Elec.</u> (type power)			
(7) electric log <u>No</u> (yes or no) (organization running log)			
(8) how well bottom plugged <u>Steel & Pipe</u>			
DRILLERS REMARKS:			


CODED

RECEIVED
FEB 22 1978

MISS. BD. OF WATER COMM

If well telescopes please sketch and show depths.

GROUND LEVEL

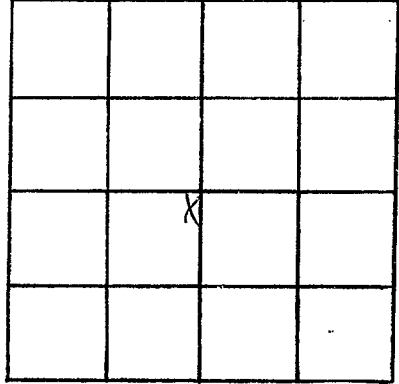

SECTION 12

Please indicate well location X.

ADDITIONAL INFORMATION

Lined area for additional information.

If more than one screen, show locations of each on sketch.