

KASH.  
 N67  
 2/3/78

MISSISSIPPI  
 BOARD OF WATER COMMISSIONERS  
 416 North State Street  
 Jackson, Mississippi 39201

**CODED**

**WATER WELL DRILLERS LOG**

2-3-1978 date well completed      Layne Central Co. firm name      Washington county well located

| LANDOWNER:  | description of formations encountered | from | to  |
|---|---------------------------------------|------|-----|
| H.T. Cochran & Son<br>Hollandale, MS 38748<br>(mailing address)   |                                       |      |     |
|   | Fine Brown Sand                       | 34   | 50  |
|   | Pea Gravel Sand                       | 50   | 60  |
|   | Gravel Sand                           | 60   | 120 |
| <b>WELL LOCATION:</b>   |                                       |      |     |
| sec. <u>11</u> T <u>15</u> N R <u>8</u> W<br>6 miles West Holandale<br>(distance) (direction) of (nearest town) |                                       |      |     |
| <b>WELL PURPOSE:</b> Irrigation<br>(home, irrigation, municipal, industrial)                                    |                                       |      |     |
| <b>WELL COMPLETION DATA:</b>  |                                       |      |     |
| (1) diameter (inches) <u>16"</u>  | <b>CODED</b>                          |      |     |
| (2) total depth (feet) <u>120'</u>  |                                       |      |     |
| (3) static water level (feet) <u>16'</u> below top of ground.   |                                       |      |     |
| (4) casing <u>Steel</u> , <u>70'</u><br>(material) (depth)  |                                       |      |     |
| <u>16"</u> If telescope see back.<br>(size)   |                                       |      |     |
| (5) screen <u>50'</u> , <u>70'</u><br>(length) (depth to top)   |                                       |      |     |
| <u>16"</u> <u>St. Steel</u><br>(size) (material)  |                                       |      |     |
| (6) pump <u>60</u> , <u>2500</u><br>(HP) (yield-gpm)  |                                       |      |     |
| <u>diesel</u><br>(type power)   |                                       |      |     |
| (7) electric log <u>No.</u><br>(yes or no)  |                                       |      |     |
| (organization running log)  |                                       |      |     |
| (8) how well bottom plugged <u>St. Plate</u>  |                                       |      |     |
| <b>DRILLERS REMARKS:</b>  |                                       |      |     |


**RECEIVED**

MAR 14 1978

MISS. BD. OF WATER COMMISSIONERS

If well telescopes please  
sketch and show depths.

GROUND LEVEL

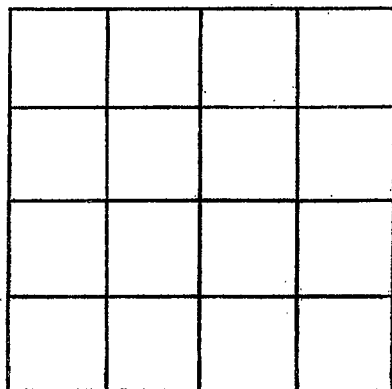

SECTION \_\_\_\_\_

Please indicate well location X.

ADDITIONAL INFORMATION

If more than one screen,  
show locations of each on sketch.