

WASHINGTON  
 N 68  
 3/22/78

MISSISSIPPI  
 BOARD OF WATER COMMISSIONERS  
 416 North State Street  
 Jackson, Mississippi 39201

CODED

WATER WELL DRILLERS LOG  
 BUTANE GAS COMPANY

3-22-78  
 date well completed

OF GREENWOOD

Washington  
 county well located


LANDOWNER:	description of formations encountered	from	to
LONGWOOD FARMS			
HOLLANDALE (mailing address)	SAND	30	40
WELL LOCATION:	SAND + Pea GRAVEL	40	60
sec. 18 T 15 N R 8 E	SAND + GRAVEL	60	100
6 W			
0 miles of LONGWOOD			
(distance) (direction) (nearest town)			
WELL PURPOSE: FRR (home, irrigation, municipal, industrial)			
WELL COMPLETION DATA:			
(1) diameter (inches) 16"			
(2) total depth (feet) 100			
(3) static water level (feet) 4 below top of ground.			
(4) casing Steel 60 (material) (depth)			
16" if telescope see back. (size)			
(5) screen 40 60 (length) (depth to top)			
16" Steel (size) (material)			
(6) pump 30 1800 (HP) (yield gpm)			
Elec. (type power)			
(7) electric log no (yes or no)			
(organization running log)			
(8) how well bottom plugged Steel Plate			
DRILLERS REMARKS:			

RECEIVED  
 MAR 30 1978

MISSISSIPPI BOARD OF WATER COMMISSIONERS

If well telescopes please sketch and show depths.

GROUND LEVEL

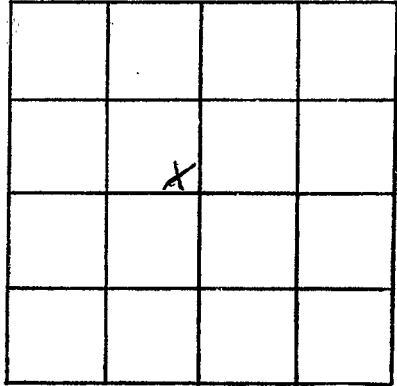

SECTION 18

Please indicate well location X.

ADDITIONAL INFORMATION

Lined area for additional information.

If more than one screen, show locations of each on sketch.