

WASHINGTON
N 69
2/18/78

MISSISSIPPI
BOARD OF WATER COMMISSIONERS
416 North State Street
Jackson, Mississippi 39201

CODED

WATER WELL DRILLERS LOG

February 18 1978 Dyer Well & Irrigation Washington
date well completed firm name county well located

LANDOWNER: <u>Leo Williams</u>	description of formations encountered	from	to
<u>Hollandale, Miss.</u> (mailing address)	<u>Clay</u>	<u>0</u>	<u>13</u>
	<u>Clay</u>	<u>14</u>	<u>23</u>
	<u>Clay</u>	<u>24</u>	<u>33</u>
WELL LOCATION: sec. <u>17</u> T. <u>15</u> N. R. <u>S</u> E. <u>W</u>	<u>FINE SAND</u>	<u>34</u>	<u>43</u>
<u>10</u> miles <u>West</u> of <u>Hollandale</u> (distance) (direction) (nearest town)	<u>FINE SAND</u>	<u>43</u>	<u>53</u>
WELL PURPOSE: <u>Irrigation</u> (home, irrigation, municipal, industrial)	<u>FINE SAND</u>	<u>54</u>	<u>62</u>
WELL COMPLETION DATA:	<u>SAND + GRAVEL</u>	<u>63</u>	<u>113</u>
(1) diameter (inches) <u>16"</u>			
(2) total depth (feet) <u>113'</u>			
(3) static water level (feet) <u>18'</u> below above top of ground.			
(4) casing <u>Steel</u> , <u>73'</u> (material) (depth)			
<u>16"</u> (size) if telescope see back.			
(5) screen <u>40'</u> , <u>73'</u> (length) (depth to top)			
<u>16"</u> , <u>Steel</u> (size) (material)			
(6) pump <u>60</u> <u>3,000</u> (HP) (yield gpm)			
<u>Diesel</u> (type power)			
(7) electric log <u>No</u> (yes or no)			
(organization running log)			
(8) how well bottom plugged <u>Plate</u>			
DRILLERS REMARKS:			

Bottom 113'


Miss. Board of Water Comm.

FEB 8 1978

RECEIVED

If well telescopes please sketch and show depths.

GROUND LEVEL

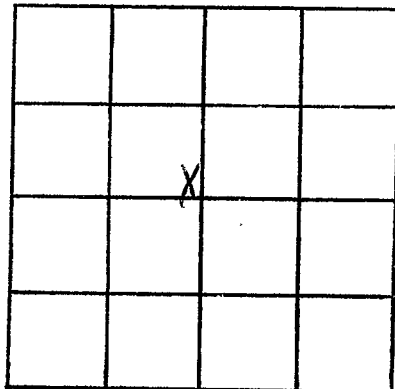

SECTION 17

Please indicate well location X.

ADDITIONAL INFORMATION

Lined area for additional information.

If more than one screen, show locations of each on sketch.