

WASHINGTON
N 71
4/3/79

MISSISSIPPI
BOARD OF WATER COMMISSIONERS
416 North State Street
Jackson, Mississippi 39201

CODED

WATER WELL DRILLERS LOG
BUTANE GAS COMPANY

4-3-79 19
date well completed

OF GREENWOOD

WASHINGTON
county well located

LANDOWNER:
LONGWOOD FARMS
HOLLANDALE
(mailing address)

| description of formations encountered | from | to |
|---------------------------------------|------|-----|
| CLAY | 0 | 30 |
| FINE SAND | 30 | 50 |
| COARSE SAND | 50 | 85 |
| SAND & PEA GRAVEL | 85 | 120 |

WELL LOCATION:
sec. 13 T. 15 N. R. 8 W.
5 1/2 miles E of Longwood
(distance) (direction) (nearest town)

CODED

WELL PURPOSE: IRR
(home, irrigation, municipal, industrial)

- WELL COMPLETION DATA:
- (1) diameter (inches) 16"
 - (2) total depth (feet) 120
 - (3) static water level (feet) 16 below top of ground.
 - (4) casing Steel 80 (material) (depth)
16" (size) if telescope see back.
 - (5) screen 40 80 (length) (depth to top)
16" (size) Steel (material)
 - (6) pump 60 2400 (HP) (yield gpm)
Diesel (type power)
 - (7) electric log NO (yes or no)
(organization running log)
 - (8) how well bottom plugged
Steel Plate

DRILLERS REMARKS:


Miss. Board of Water Comm.

APR 18 1979

RECEIVED

If well telescopes please sketch and show depths.

GROUND LEVEL

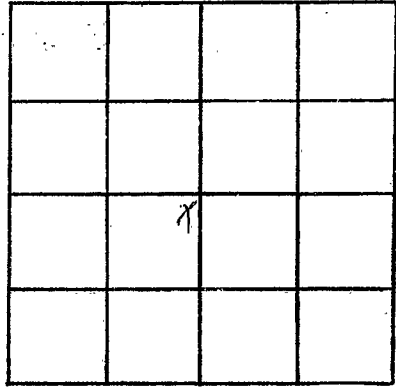

SECTION 13

Please indicate well location X.

ADDITIONAL INFORMATION

If more than one screen, show locations of each on sketch.