

WASHINGTON
N 72
6/19/79

MISSISSIPPI
BOARD OF WATER COMMISSIONERS
416 North State Street
Jackson, Mississippi 39201

CODED

WATER WELL DRILLERS LOG
BUTANE GAS COMPANY

6-19-79
date well completed

OF GREENWOOD
name of town

Washington
county well located

LANDOWNER:	description of formations encountered	from	to
Longwood Farms			
Hollandale	SAND & Pea Gravel	51	70
(mailing address)	SAND	70	80
	SAND & GRAVEL	80	100

WELL LOCATION:
sec. 12 T 15 N R 8 W
4 1/2 miles NE of Longwood
(distance) (direction) (nearest town)

CODED

WELL PURPOSE: FRR
(home, irrigation, municipal, industrial)


- WELL COMPLETION DATA:
- diameter (inches) 16
 - total depth (feet) 100
 - static water level (feet) 16 below top of ground.
 - casing Steel 60 (material), (depth)
16 (size) if telescope see back.
 - screen 40 (length), 60 (depth to top)
16 (size), Steel (material)
 - pump 60 (HP), 2500 (yield gpm)
Diesel (type power)
 - electric log No (yes or no)
- (organization running log)
- (8) how well bottom plugged Steel Plate

DRILLERS REMARKS:

Miss. Board of Water Comm.
JUL 11 1979
RECEIVED

If well telescopes please sketch and show depths.

GROUND LEVEL

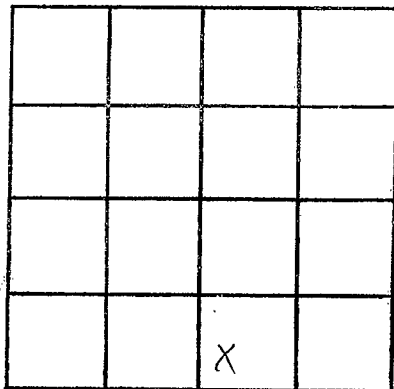

SECTION 12

Please indicate well location X.

ADDITIONAL INFORMATION

If more than one screen,
show locations of each on sketch.