

WASHINGTON

CL-1124 N 73

3-21-79

MISSISSIPPI BOARD OF WATER COMMISSIONERS
416 North State Street
Jackson, Mississippi 39201

CODED

WATER WELL DRILLERS LOG

3-21-
date well completed

19 79 LAYNE CENTRAL COMPANY
firm name

WASHINGTON
county well located

LANDOWNER:

Opossum Ridge Farms

Hollandale, MS
(mailing address)

description of formations
encountered

Clay

Silt

Sand

Sand-Pea Gravel

Coarse Sand-Gravel

from

to

0

5

5

20

20

40

40

60

60

106

WELL LOCATION:

sec. 12 T. 15 N R. 8 W

6 miles West of Hollandale
(distance) (direction) (nearest town)

WELL PURPOSE: Irrigation
(home, irrigation, municipal, industrial)

WELL COMPLETION DATA:

- (1) diameter (inches) 12"
- (2) total depth (feet) 106'
- (3) static water level (feet) 8' 3" below above top of ground.
- (4) casing Steel, 66',
(material) (depth)
12" If telescope see back.
(size)
- (5) screen 40, 66'
(length) (depth to top)
12", St. Steel
(size) (material)
- (6) pump 25 1500
(HP) (yield gpm)
Diesel
(type power)
- (7) electric log No
(yes or no)

(organization running log)

(8) how well bottom plugged St. Plate

DRILLERS REMARKS:

CODED


Miss. Board of Water Comm.

SEP 12 1979

RECEIVED

If well telescopes please sketch and show depths.

GROUND LEVEL

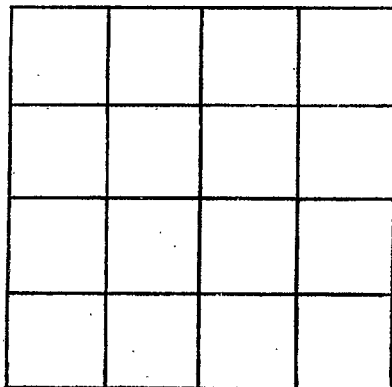

SECTION _____

Please indicate well location X.

ADDITIONAL INFORMATION

If more than one screen, show locations of each on sketch.