

Washington

MISSISSIPPI DEPARTMENT OF NATURAL RESOURCES
Bureau of Land and Water Resources
Southport Mall
P.O. Box 10631
Jackson, Mississippi 39209
WATER WELL DRILLERS LOG

CODED

N-75
6/12/80

6/04/80 19 Larrys Well & Pump Washington
date well completed firm name county well located

LANDOWNER: Ernest Stone

description of formations encountered from to

Greenville MS.
(mailing address)

Clay 0' 23'
fine sand 23' 45'
med sand 45' 55'
coarse sand 55' 93'
coarse sand & gravel 93' 109'

WELL LOCATION:
sec. 33 T 15 S R 8 E
1 miles NE of Erwin
(distance) (direction) (nearest town)

WELL PURPOSE: Irrigation
(home, irrigation, municipal, industrial)

WELL COMPLETION DATA:

- (1) diameter (inches) 12"
- (2) total depth (feet) ~~108~~ 109'
- (3) static water level (feet) 17' below top of ground.
- (4) casing Steel, 69' (material) (depth)
if telescope see back.
- (5) screen 40' length, 69' depth to top
12" size, Steel material
- (6) pump 80 HP, 1000 yield gpm
diesel type power
- (7) electric log NO (yes or no)
(organization running log)
- (8) how well bottom plugged steel plate

DRILLERS REMARKS:


DEPT. OF NATURAL RESOURCES
BUREAU OF LAND & WATER RESOURCES

JUL 28 1980

RECEIVED

If well telescopes please
sketch and show depths.

GROUND LEVEL

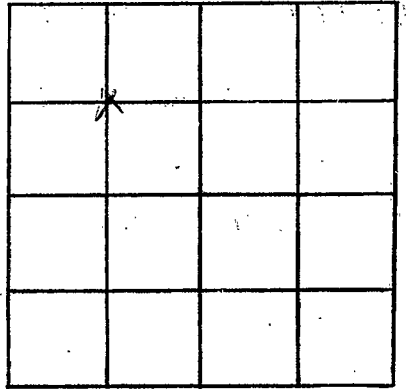

SECTION 35

Please indicate well location X.

ADDITIONAL INFORMATION

If more than one screen,
show locations of each on sketch.