

MISSISSIPPI DEPARTMENT OF NATURAL RESOURCES

Bureau of Land and Water Resources

Southport Mall

P.O. Box 10631

Jackson, Mississippi 39209

WATER WELL DRILLERS LOG

Washington
N-76
5/6/81
5-6-81

3 wells

CODED
Wash.

date well completed

19

firm name

county well located

Dyerwell Dring

Sharky

LANDOWNER:

Leo Williams

description of formations encountered

from

to

Hollandale, Miss.
(mailing address)

Clay	0	28
Fine Sand	28	36
Sand	36	56
Sand + Gravel	56	111

WELL LOCATION:

sec. 10 T. 15 (N) R. 8 (E)
S (W)
10 miles W of Hollandale
(distance) (direction) (nearest town)

WELL PURPOSE:

(home, irrigation, municipal, industrial)

WELL COMPLETION DATA:

- (1) diameter (inches) 16"
- (2) total depth (feet) 111'
- (3) static water level (feet) 19' below top of ground.
- (4) casing Steel, 111',
(material) (depth)
16" if telescope see back.
(size)
- (5) screen 40', 71'
(length) (depth to top)
16", Steel
(size) (material)
- (6) pump 60, 3000
(HP) (yield gpm)
electric
(type power)
- (7) electric log no
(yes or no)

CODED

(organization running log)

(8) how well bottom plugged plate

DRILLERS REMARKS:


DEPT. OF NATURAL RESOURCES
BUREAU OF LAND & WATER RESOURCES

MAY 19 1981

RECEIVED

If well telescopes please sketch and show depths.

GROUND LEVEL

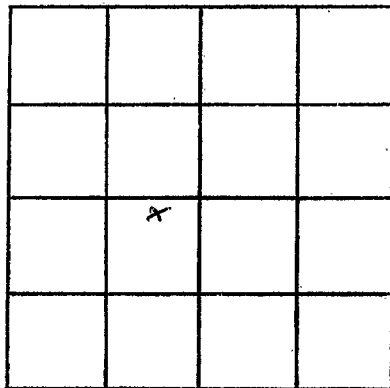

SECTION 10

Please indicate well location X.

ADDITIONAL INFORMATION

If more than one screen,
show locations of each on sketch.