

Washington  
N77  
10-24-80

Bureau of Land and Water Resources  
Southport Mall  
P.O. Box 10631  
Jackson, Mississippi 39209  
WATER WELL DRILLERS LOG

3255

10/24/80 date well completed  
Dyer firm name  
Washington county well located

LANDOWNER:

LEO WILLIAMS

description of formations encountered

CODED

from to

Holladay, MS  
(mailing address)

Clay  
Sand & Gravel

0 53  
53 100

WELL LOCATION:

sec. 10 T 150 N R 8 E  
W of Holladay  
(distance) miles (direction) of (nearest town)


WELL PURPOSE:

(home, irrigation, municipal, industrial)


WELL COMPLETION DATA:

- (1) diameter (inches) 16"
- (2) total depth (feet) 100'
- (3) static water level (feet) 21' below top of ground.
- (4) casing (material) Steel (depth) 100'
- (5) screen (size) 16" (length) 40' (depth to top) 60'
- (6) pump (size) 16" (material) Steel (HP) 60 (yield gpm) 3000'
- (7) electric log (type power) Electric (yes or no)
- (8) how well bottom plugged plate

CODED

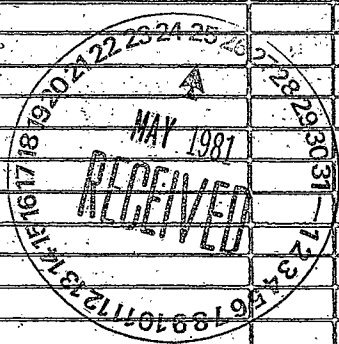

DRILLERS REMARKS:

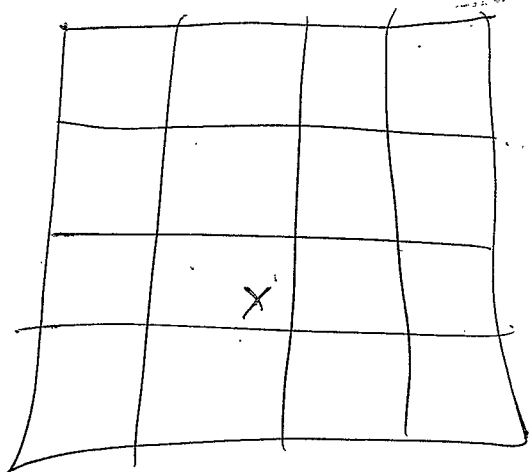

Sec 5