

Bureau of Land and Water Resources

Southport Mall

P.O. Box 10631

Jackson, Mississippi 39209

WATER WELL DRILLERS LOG


3317

Washington  
N 78  
11-11-80

11/71 19 80 Page Wash  
date well completed farm name county well located

LANDOWNER:	description of formations encountered	CODED	from	to
C. G. STEELE, JR.  (mailing address)	Clay		0	20
	Fine Sand		20	25
WELL LOCATION: sec. <u>21</u> T. <u>15</u> N. R. <u>8</u> E. <u>2</u> miles <u>E</u> <u>Logwood</u> (distance) (direction) (nearest town)	Sand + Gravel		45	60
	Clay		60	75
WELL PURPOSE: (home, irrigation, municipal, industrial)	Fine + Gravel		75	113
WELL COMPLETION DATA:				
(1) diameter (inches) <u>16</u>				
(2) total depth (feet) <u>113'</u>				
(3) static water level (feet) <u>22'</u> below top of ground.				
(4) casing <u>Steel</u> <u>113'</u> (material) (depth)				
<u>16"</u> If telescope see back. (size)				
(5) screen <u>40'</u> <u>73'</u> (length) (depth to top)				
<u>16"</u> <u>Steel</u> (size) (material)				
(6) pump <u>60</u> <u>3000</u> (HP) (yield gpm)				
<u>Drum</u> (type power)				
(7) electric log (yes or no)				
(organization running log)				
(8) how well bottom plugged <u>plate</u>				

CODED

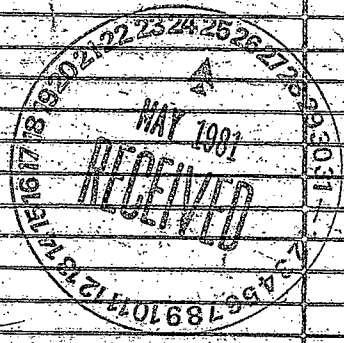

DRILLERS REMARKS:

1

		x	

See 21