

MISSISSIPPI DEPARTMENT OF NATURAL RESOURCES

Bureau of Land and Water Resources

Southport Mall

P.O. Box 10631

Jackson, Mississippi 39209

WATER WELL DRILLERS LOG

CODED

Washington
N 79
3/23/81

15N 7W P. 1 sec 15 in Hollandale

March 23 19 81

Larry's well & pump

firm name

Washington

county well located

LANDOWNER: H-T Cochran

description of formations encountered

from

to

Hollandale

(mailing address)

CLAY
FINE SAND
MED COARSE SAND

0	30
30	65
65	121

WELL LOCATION:

sec. 1 T 15 N R 7 E W
6 miles W of Hollandale
(distance) (direction) (nearest town)

WELL PURPOSE:

(home, irrigation, municipal, industrial)

WELL COMPLETION DATA:

- (1) diameter (inches) 16"
- (2) total depth (feet) 121'
- (3) static water level (feet) 22 below top of ground.
- (4) casing Steel 81' (material) (depth)
(size) if telescope see back.
- (5) screen 40' 81' (length) (depth to top)
16" Steel (size) (material)
- (6) pump 100 3000 (HP) (yield gpm)
(type power)
- (7) electric log No (yes or no)
(organization running log)
- (8) how well bottom plugged steel Plate

CODED

REPT. OF NATURAL RESOURCES
BUREAU OF LAND & WATER RESOURCES


OCT 19 1981

RECEIVED

DRILLERS REMARKS:

If well telescopes please sketch and show depths.

GROUND LEVEL

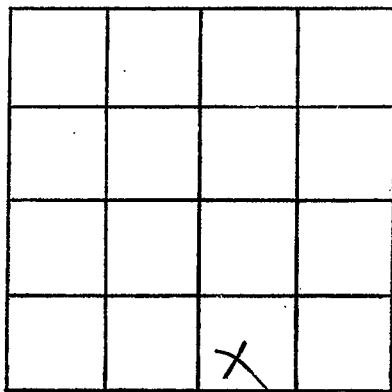

SECTION 1

Please indicate well location X.

ADDITIONAL INFORMATION

If more than one screen, show locations of each on sketch.