

MISSISSIPPI DEPARTMENT OF NATURAL RESOURCES

Bureau of Land and Water Resources

Southport Mall

P.O. Box 10631

Jackson, Mississippi 39209

**CODED**

WASHINGTON  
N 83  
5-5-82  
FW # 102

151N0083

UN, IT WATER WELL DRILLERS LOG

5 May  
date well completed

82 Lambert Drilling  
firm name

Wash  
county well located

LANDOWNER: AIR FORCE	description of formations encountered	from	to
Space Surveillance			
3 Silver Lake, Miss. (mailing address)	Clay	0	10
WELL LOCATION:	Yellow sand	10	15
sec. 16 T 5 N R 8 E 20 miles S of Greenville (distance) (direction) (nearest town)	Sand	15	75
WELL PURPOSE: Dml. (home, irrigation, municipal, industrial)	fine gravel	75	95
WELL COMPLETION DATA:	blue shell <b>CODED</b>	95	105
(1) diameter (inches) 4	Clay	105	145
(2) total depth (feet) 150	Sand	145	305
(3) static water level (feet) 36 below top of ground	Clay	305	350
(4) casing Steel, 720. (material) (depth)	Sand fine	350	600
1 if telescope see back. (size)	Sand med	600	705
(5) screen 30, 70-720. (length) (depth to top)	Sand coarse	705	750
2 1/2, 8.5. (size) (material)	Clay	750	765
(6) pump 3, 50. (HP) (yield gpm)			
elect (type power)			
(7) electric log yes (yes or no)			
Geo Serv. (organization running log)			
(8) how well bottom plugged break test			
DRILLERS REMARKS: Pulled pump and welded cap on top of casing			

DEPT. OF NATURAL RESOURCES  
BUREAU OF LAND & WATER RESOURCES


MAY 18 1982

**RECEIVED**

10/14

If well telescopes please sketch and show depths.

GROUND LEVEL

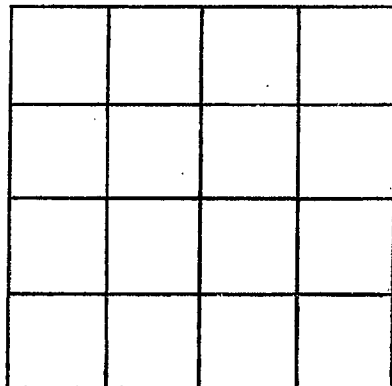

SECTION \_\_\_\_\_

Please indicate well location X.

ADDITIONAL INFORMATION

If more than one screen,  
show locations of each on sketch.