

MISSISSIPPI DEPARTMENT OF NATURAL RESOURCES
Bureau of Land and Water Resources
 Southport Mall
 P.O. Box 10631
 Jackson, Mississippi 39209
WATER WELL DRILLERS LOG

CODED

Washington
N 89
315182

35 19 82 Ober Well Washington
 date well completed firm name county well located

LANDOWNER: Leo Williams
Hollandale Miss.
 (mailing address)
 WELL LOCATION:
 sec. 11 T. 15 R. A8
 S. 7 W. of Hollandale
 (distance) (direction) (nearest town)

description of formations encountered	from	to
CLAY	0	13
Fine Sand & CLAY	13	23
Fine Sand & CLAY	23	33
Sand	33	43
COBBLE SAND	43	53
" "	53	63
C. SAND & GRAVEL	63	73
GRAVEL	73	83
C. SAND & GRAVEL	83	93
" "	93	103
" "	103	113

WELL PURPOSE:
 (home, irrigation, municipal, industrial)

WELL COMPLETION DATA:
 (1) diameter (inches) 16"
 (2) total depth (feet) 113
 (3) static water level (feet) 17 below above top of ground.
 (4) casing Steel 73
 (material) (depth)
16 if telescope see back.
 (size)
 (5) screen 40'
 (length) (depth to top)
16" Steel
 (size) (material)
 (6) pump 40 2000
 (HP) (yield gpm)
electric
 (type power)
 (7) electric log No
 (yes or no)
 (organization running log)
 (8) how well bottom plugged Plate

CODED

DEPT. OF NATURAL RESOURCES
 BUREAU OF LAND & WATER RESOURCES


MAY 19 1982

RECEIVED

DRILLERS REMARKS:

If well telescopes please sketch and show depths.

GROUND LEVEL

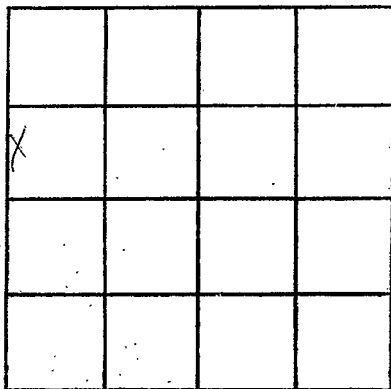

SECTION 4

Please indicate well location X.

ADDITIONAL INFORMATION

If more than one screen,
show locations of each on sketch.