

MISSISSIPPI DEPARTMENT OF NATURAL RESOURCES

Bureau of Land and Water Resources

Southport Mall

P.O. Box 10631

Jackson, Mississippi 39209

WATER WELL DRILLERS LOG

CODED

Washington
N 92
7113183

7-13 1982
date well completed

Open Well
firm name

Washington
county well located

LANDOWNER: Holly Ridge

(mailing address)

WELL LOCATION:
sec. 13 T 15 N R 9 E
S 3 miles S of Longwood
(distance) (direction) (nearest town)

description of formations encountered

from

to

Clay	0	14
Brown Sand + Gravel	14	31
Medium Sand + Gravel	36	56
Sand + Gravel	56	66
Fine Sand	66	72
Sand + Gravel	72	113

WELL PURPOSE:
(home, irrigation, municipal, industrial)

WELL COMPLETION DATA:

- (1) diameter (inches) 16
- (2) total depth (feet) 113
- (3) static water level (feet) 14 below above top of ground.
- (4) casing Steel, 73
(material), (depth)
- 16 if telescope see back.
(size)
- (5) screen 40, 73
(length), (depth to top)
- 16, Steel
(size), (material)
- (6) pump 40, 2,000
(HP), (yield gpm)
- tractor
(type power)
- (7) electric log No
(yes or no)

(organization running log)

(8) how well bottom plugged plate

DRILLERS REMARKS:

CODED


DEPT. OF NATURAL RESOURCES
BUREAU OF LAND & WATER RESOURCES

SEP 30 1982

RECEIVED

If well telescopes please sketch and show depths.

GROUND LEVEL

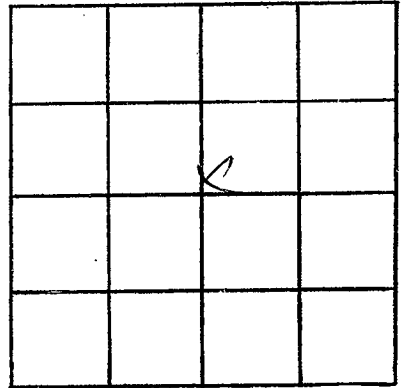

SECTION B

Please indicate well location X.

ADDITIONAL INFORMATION

If more than one screen,
show locations of each on sketch.