

MISSISSIPPI DEPARTMENT OF NATURAL RESOURCES  
 Bureau of Land and Water Resources  
 Southport Mall  
 P.O. Box 10631  
 Jackson, Mississippi 39209  
**WATER WELL DRILLERS LOG**

**CODED**

Washington  
~~CL 2246~~  
N 93  
7/28/80

7-28 1982 Layne-Central Co. Washington  
 date well completed firm name county well located

LANDOWNER: E. A. Currey  
Opossum Ridge Farm  
Hallandale, Ms 38748  
 (mailing address)

description of formations encountered	from	to
<u>clay</u>	<u>0</u>	<u>6</u>
<u>fine sand</u>	<u>6</u>	<u>30</u>
<u>pea gravel &amp; sand</u>	<u>30</u>	<u>107</u>
<u>pink clay</u>	<u>107</u>	

WELL LOCATION:  
 sec. 12 T. 15 N R. 8 W  
4 miles W of Hallandale  
 (distance) (direction) (nearest town)

WELL PURPOSE: Irrigation  
 (home, irrigation, municipal, industrial)

**CODED**

WELL COMPLETION DATA:

- (1) diameter (inches) 28"
- (2) total depth (feet) 107'
- (3) static water level (feet) 15' below above top of ground.
- (4) casing steel 67'  
 (material) (depth)  
12" if telescope see back.  
 (size)
- (5) screen 40' 67'  
 (length) (depth to top)  
12" st steel  
 (size) (material)
- (6) pump 40 2000  
 (HP) (yield gpm)  
Diesel  
 (type power)
- (7) electric log no  
 (yes or no)  
 (organization running log)
- (8) how well bottom plugged st. Plate

DRILLERS REMARKS:


DEPT. OF NATURAL RESOURCES  
 BUREAU OF LAND & WATER RESOURCES

DEC 16 1982

**RECEIVED**

If well telescopes please sketch and show depths.

GROUND LEVEL

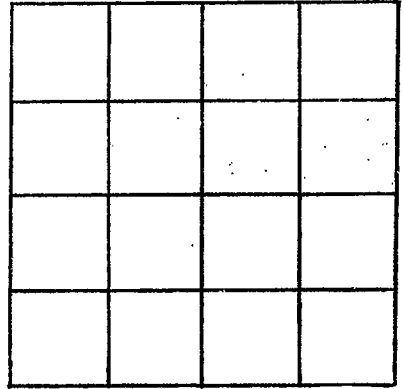

SECTION \_\_\_\_\_

Please indicate well location X.

ADDITIONAL INFORMATION

If more than one screen,  
show locations of each on sketch.